

223-04



5m

223-04

SILVER QUEEN S M MINING WORKS



Scale 30 feet to an inch

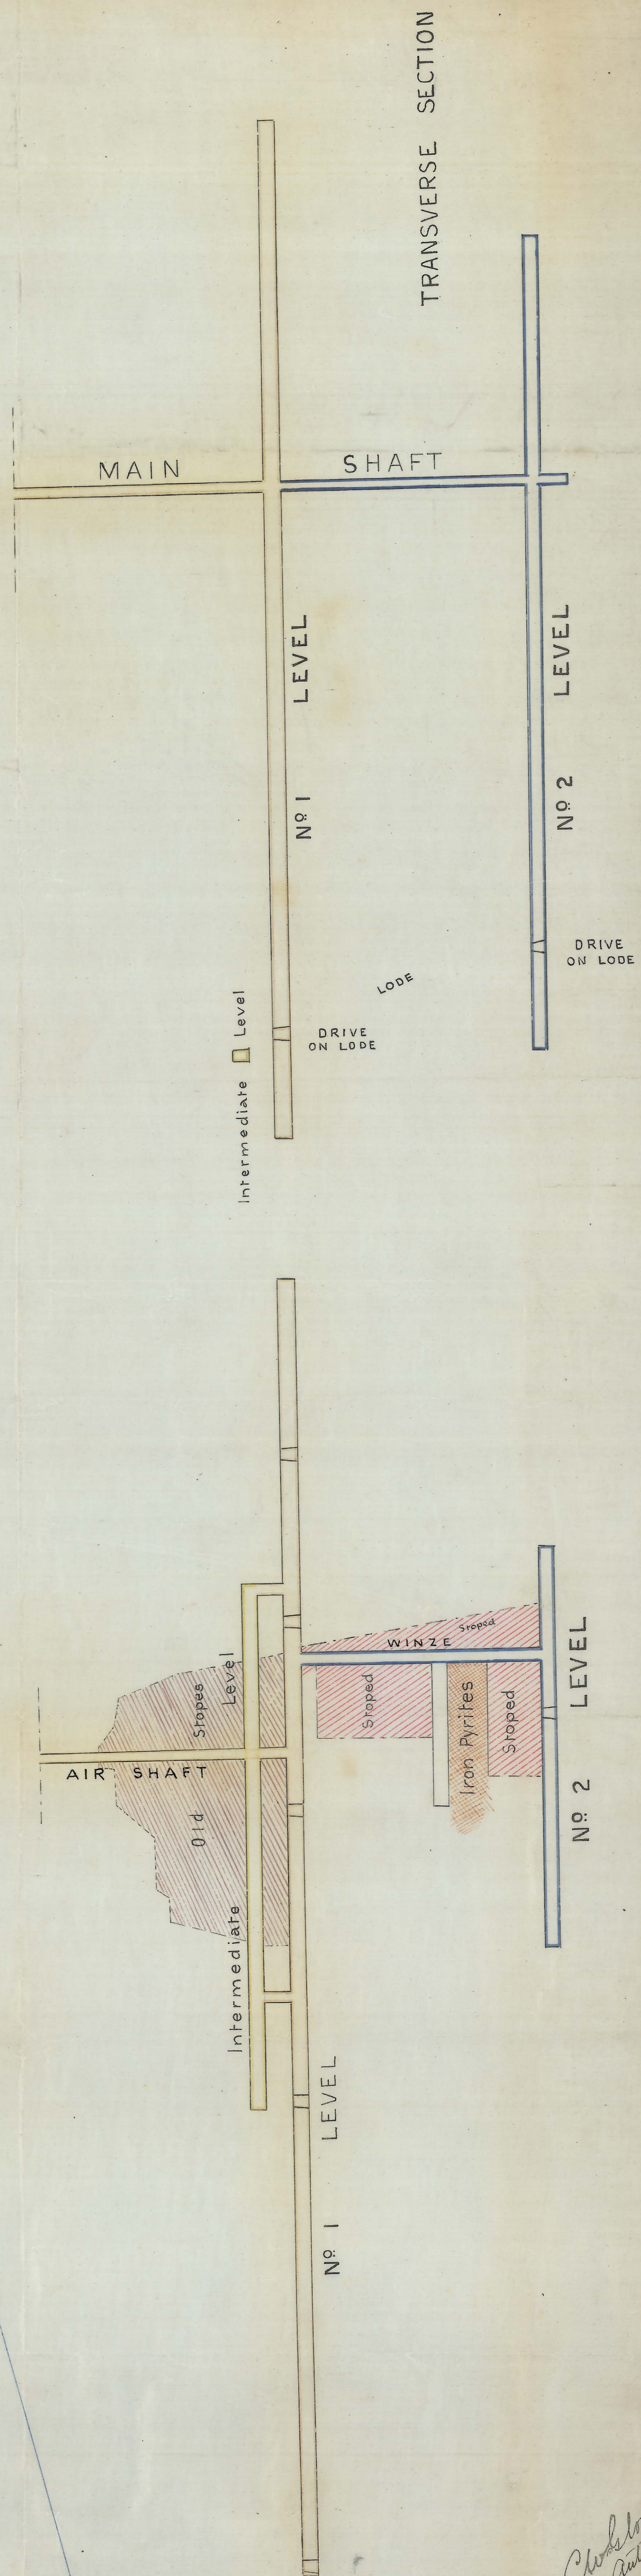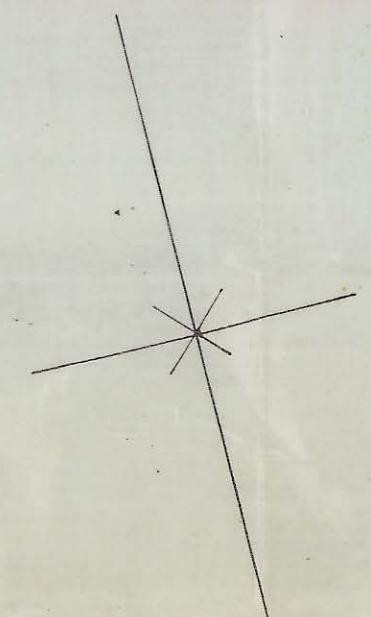

Charles
Anderson
2nd Jan 1914