
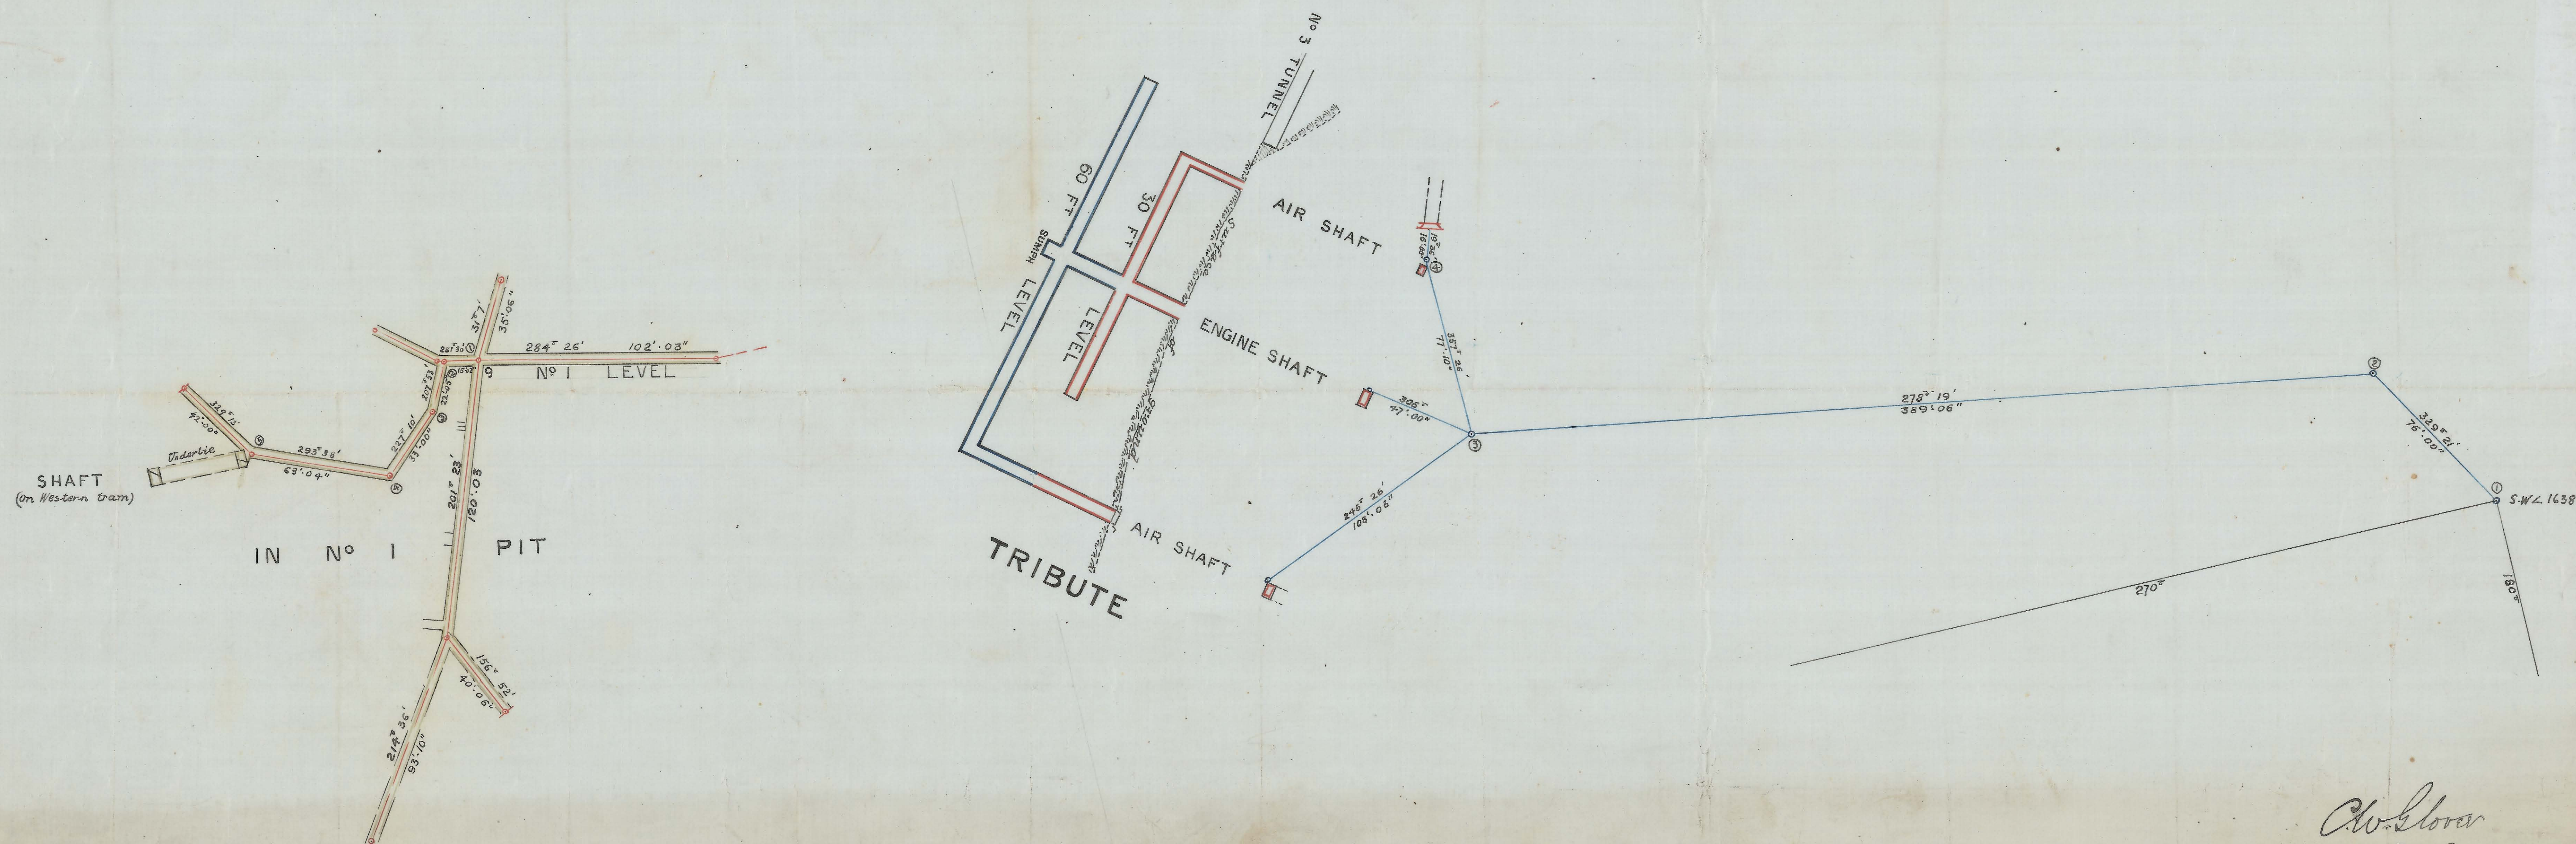


SILVER QUEEN S. M. MINING WORKS

Scale 30 feet to an inch

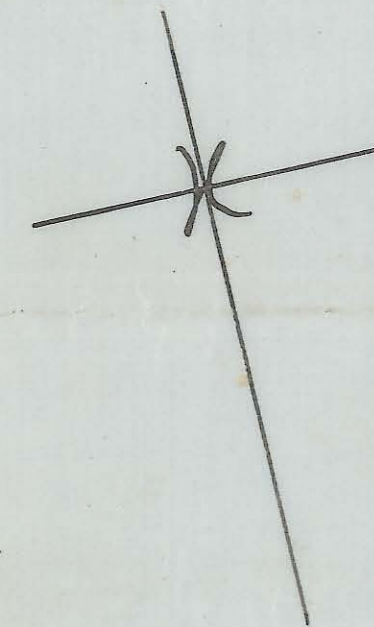

C. W. Glover
And Surveyor
Zeehan Jan '96