THE MOUNT ZEEHAN (TAS) S.L. MINES Lᵈ

QUEEN EXTENDED BLOCK 5

Scale 30 Ft to 1 In.

189
87M 80Ac

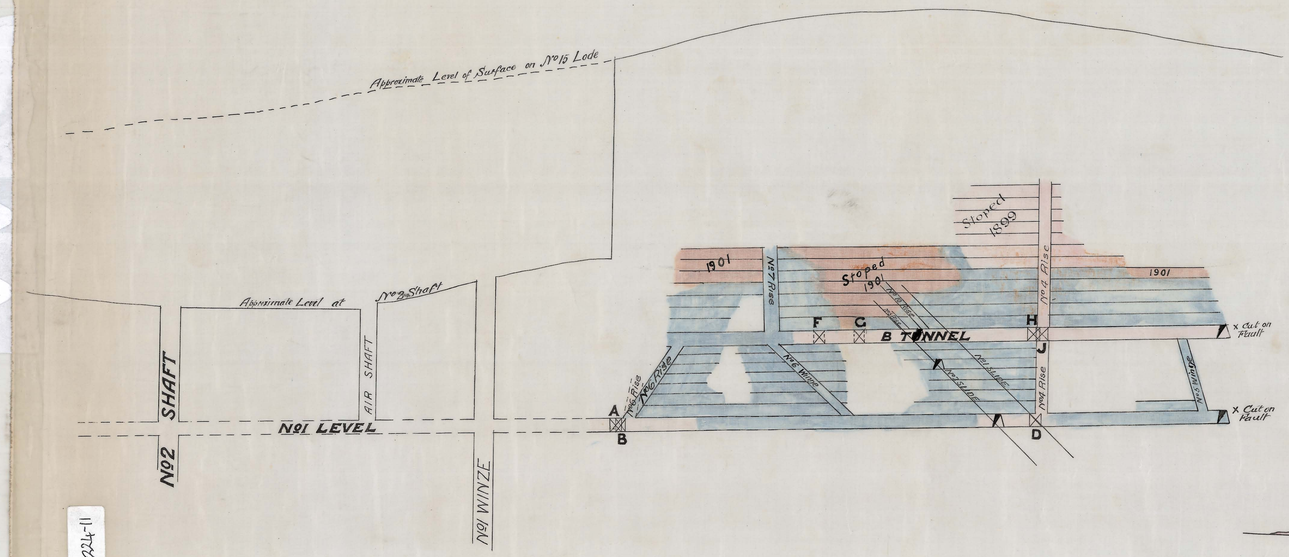

SECTION ON No 15 LODE

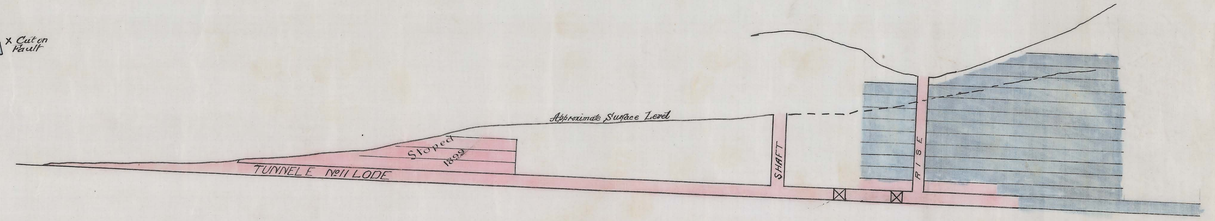

224-11

224-10 Too Levels

224-12 13 Too Levels

5 cm

224-11

24/1/01

MANAGER 23/1/01
20.12.01