
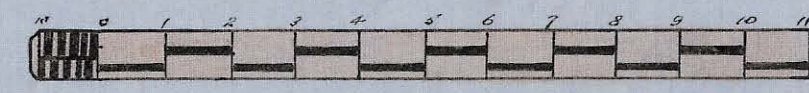


ZEEHAN-DUNDAS MINES, LTD.

SCALE 

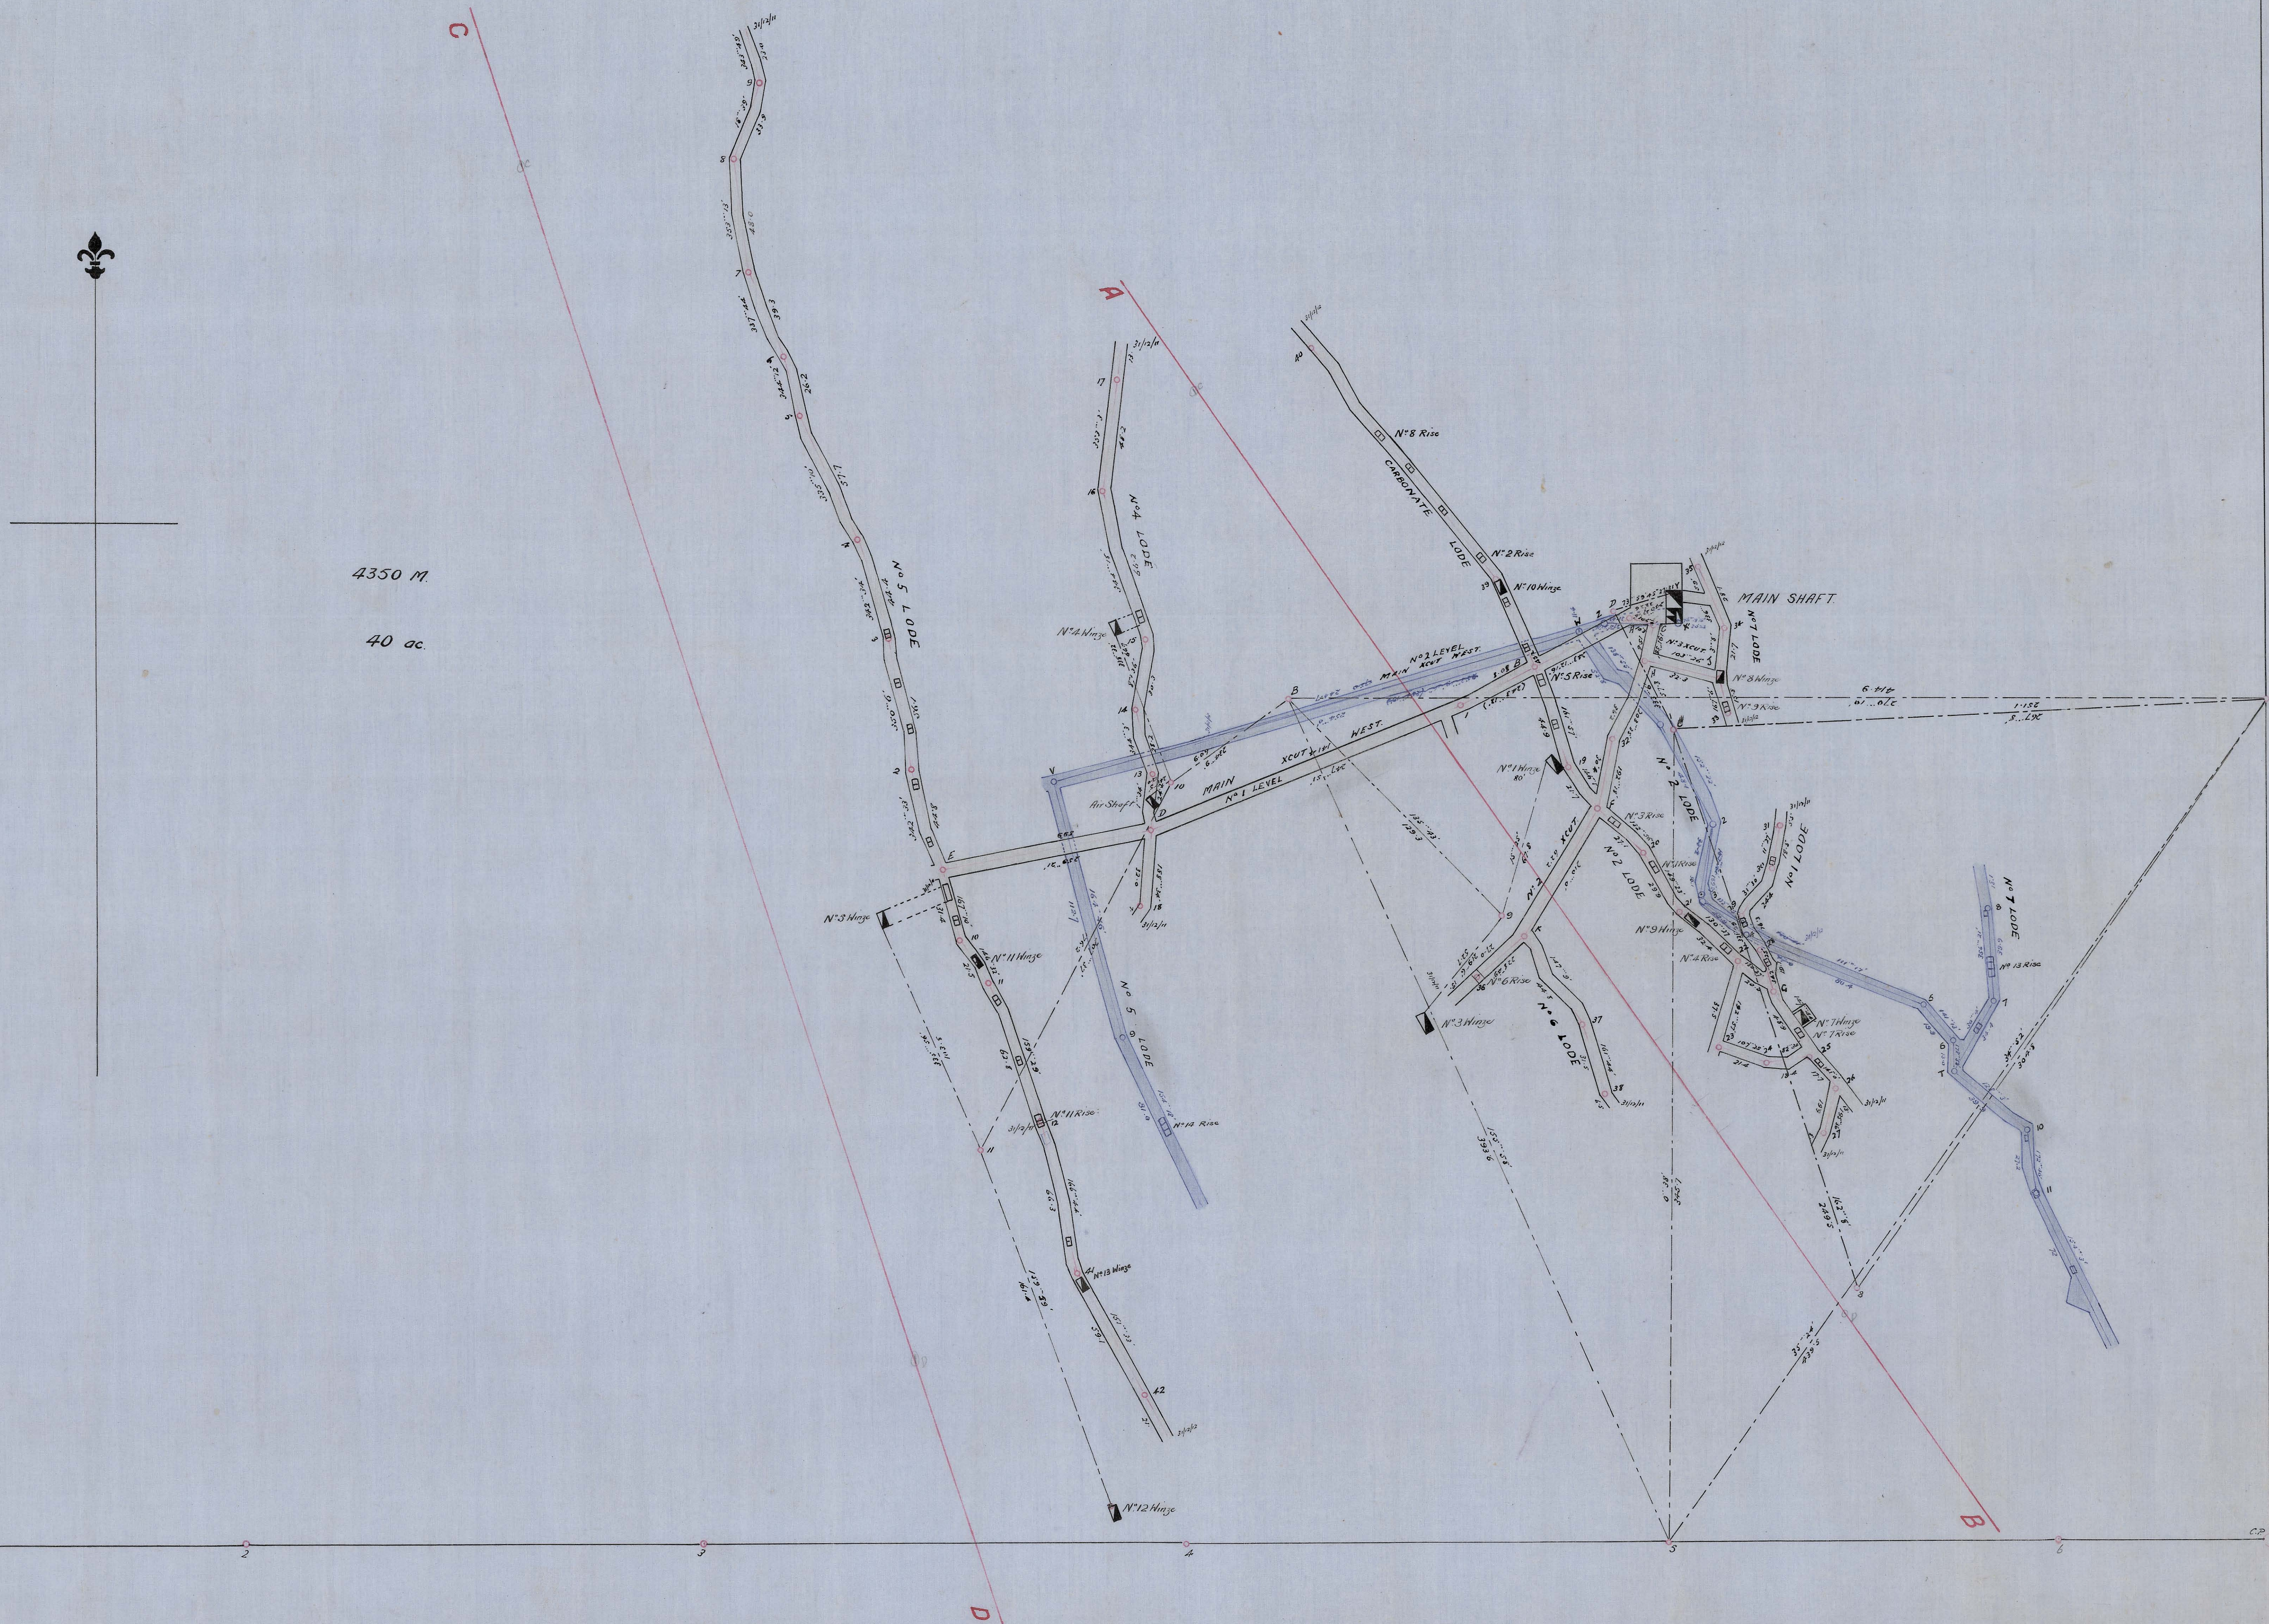

4350 M

40 ac.

4373 M

40 ac.

Z. D. M.

REFERENCE.
 { N°1 Level Shong
 { N°2 " " }

4369 M

80 ac.

W. Allen

L.H. Munn

Min. Manager

27.3.13.

L.H. Munn 27 MAY 1914