


0226-003

5 cm

THE TASMANIA GOLD MINING CO. LTD.

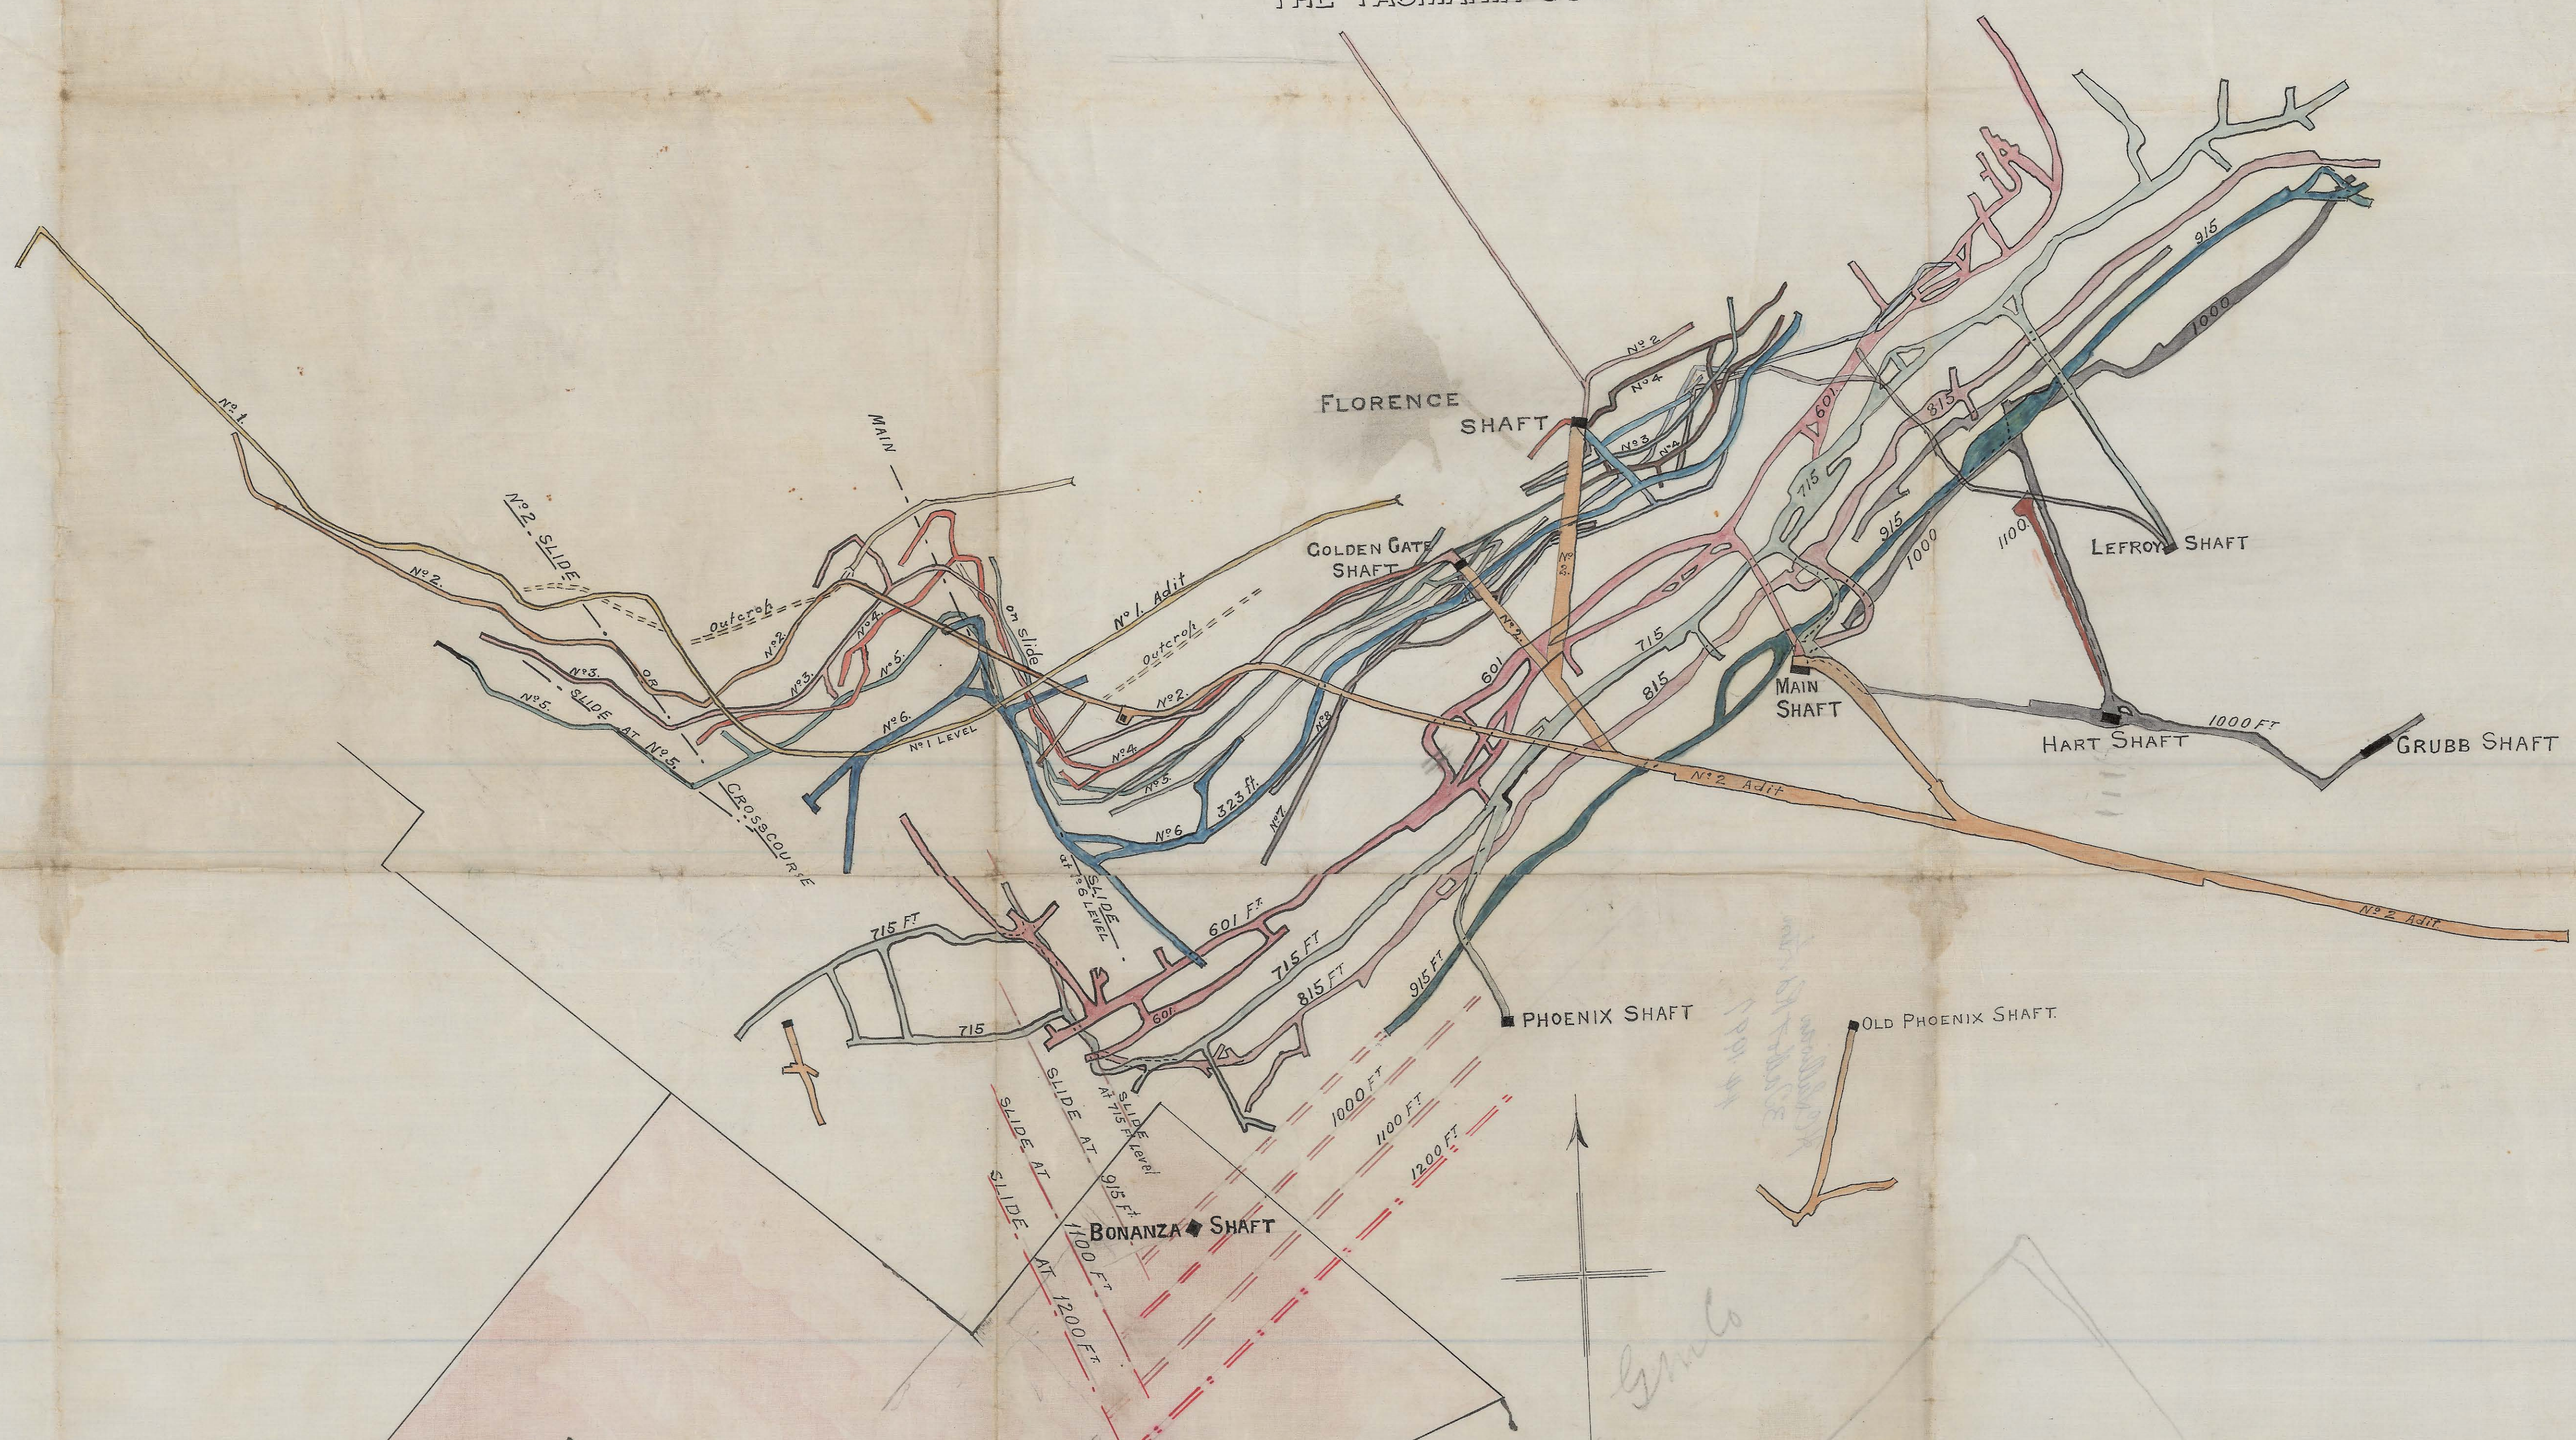

THE BONANZA PROPRIETARY, No 11A.

SCALE: 100 FEET = 1 INCH.

Bonanza

63 acres
25 acres making
Italy area