

5 cm

227-02

227-01
TOO LARGE


227-02

SECTION

SCALE 25 FEET TO ONE INCH

S

N

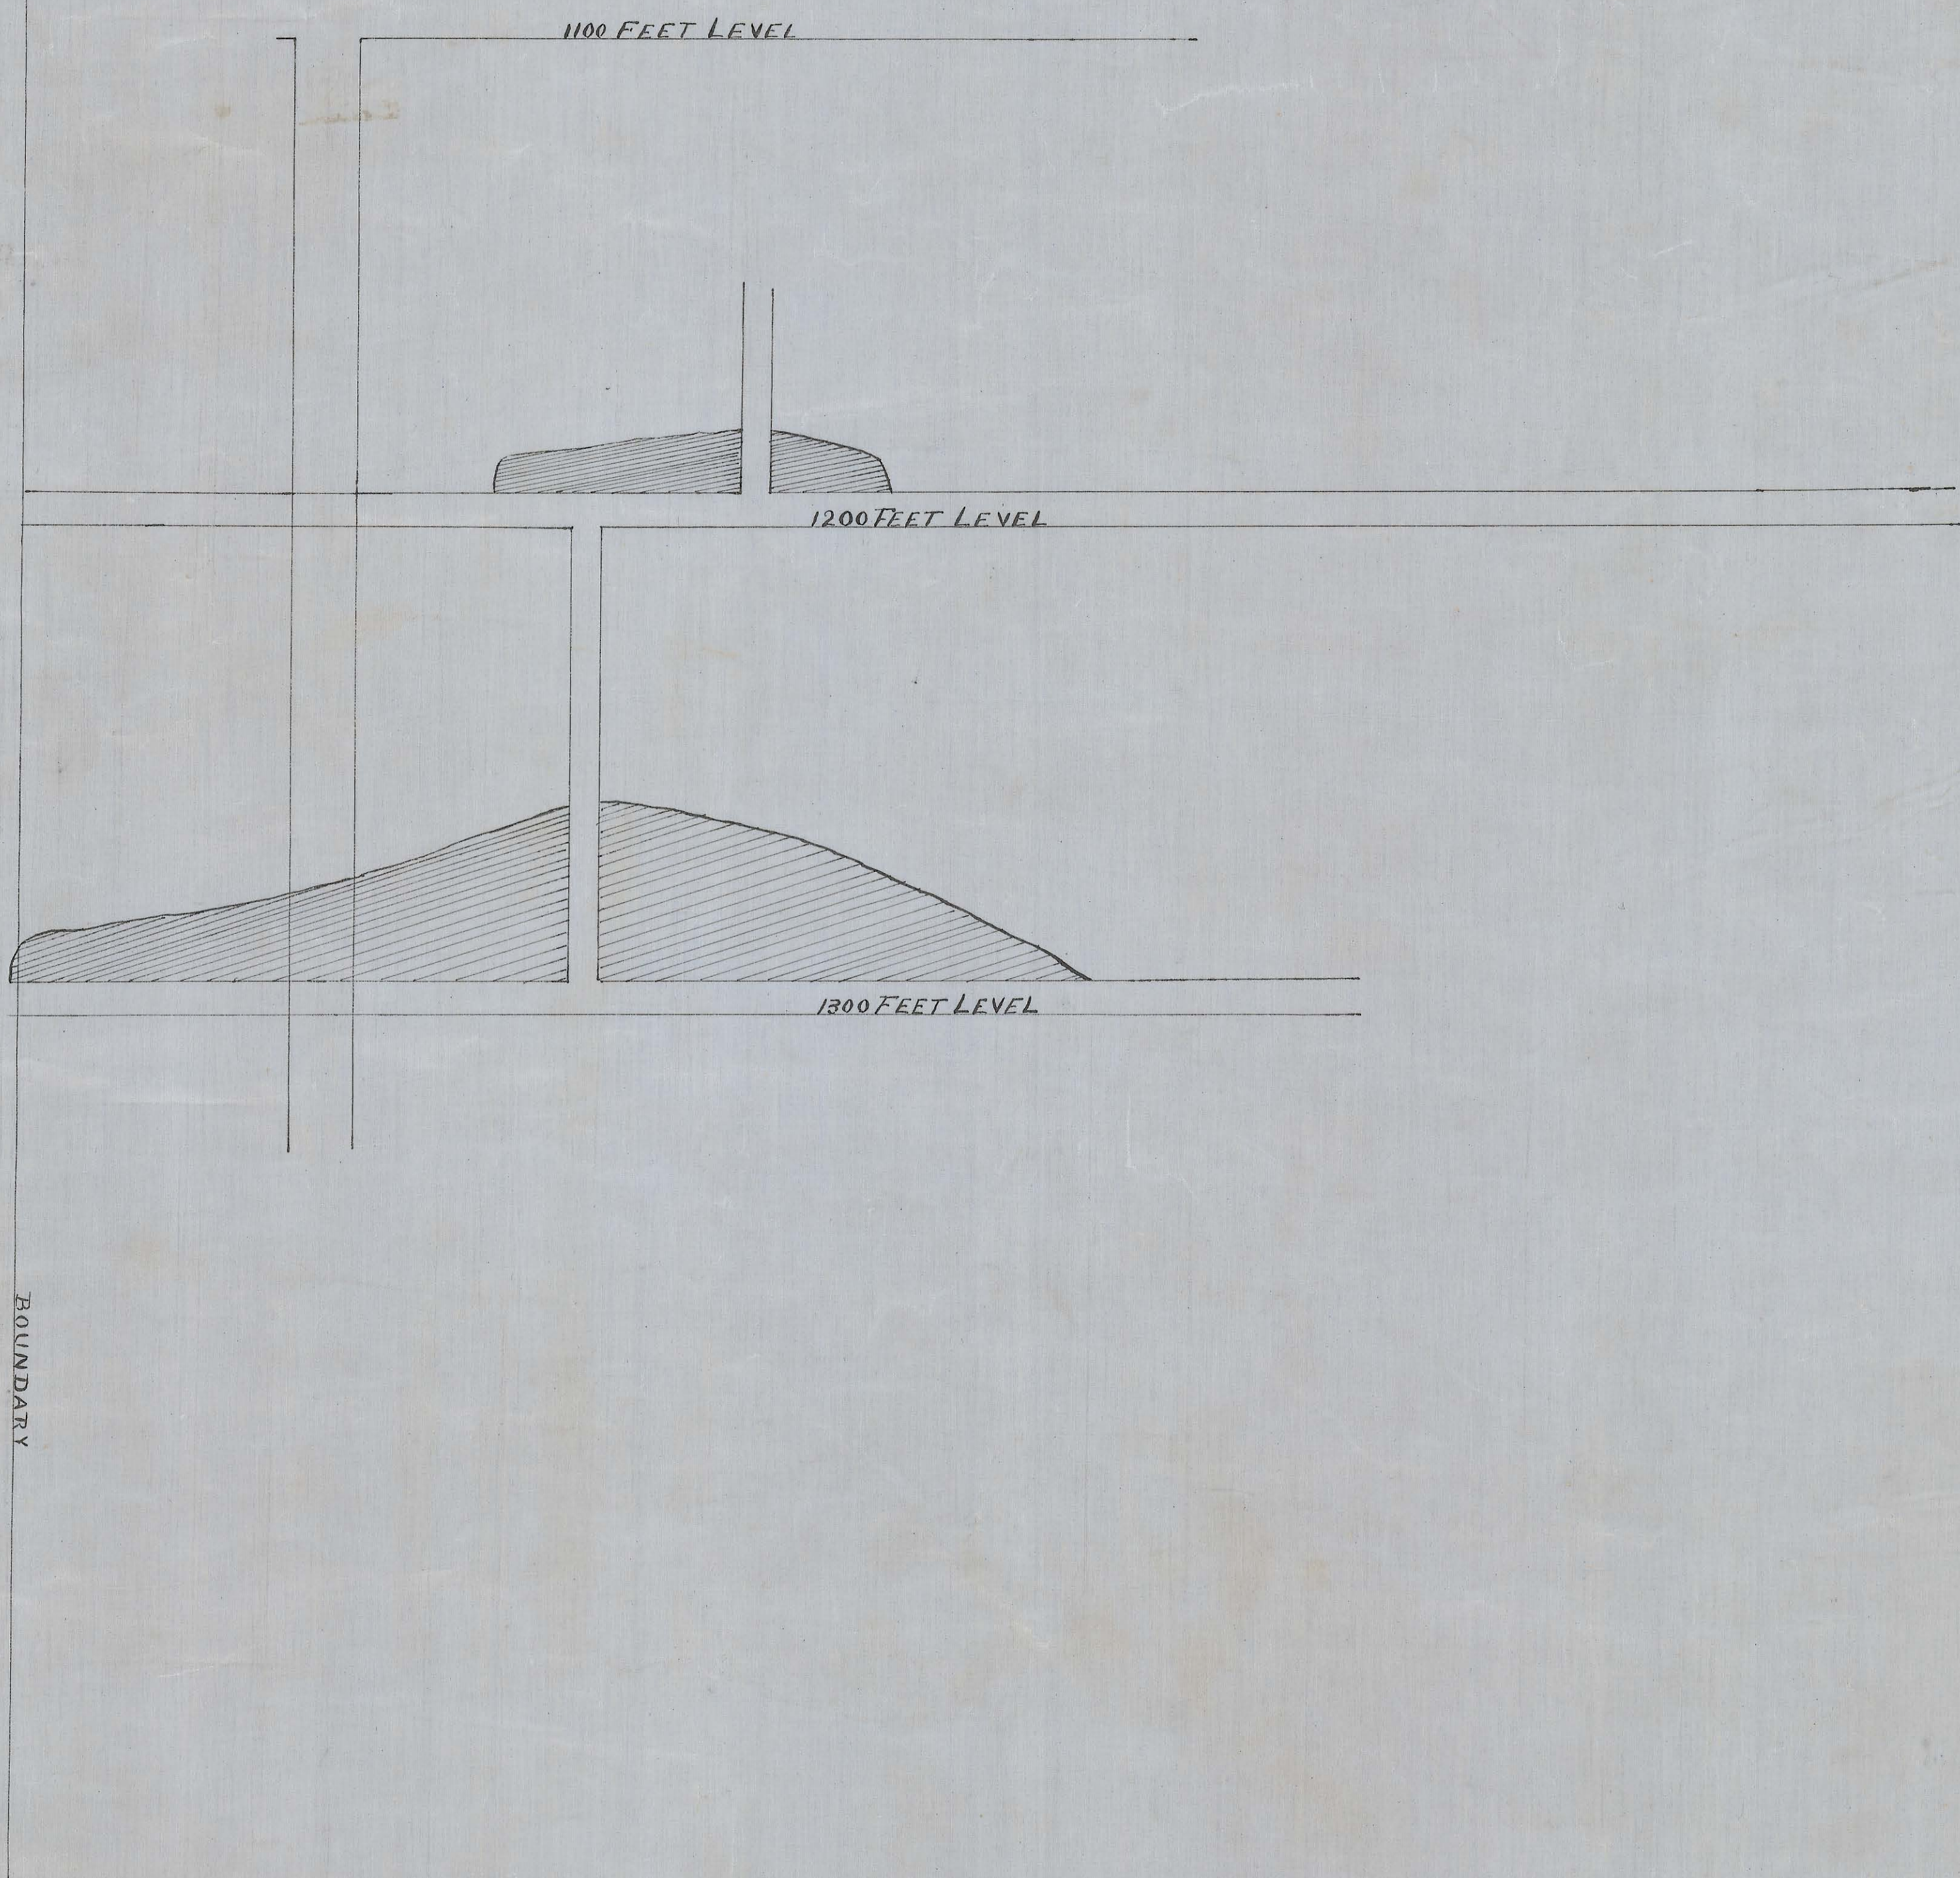

S. J. Andrew
April 1905



Andrew