TASMANIAN COLDEN GATE MINE

228-02

PLAN

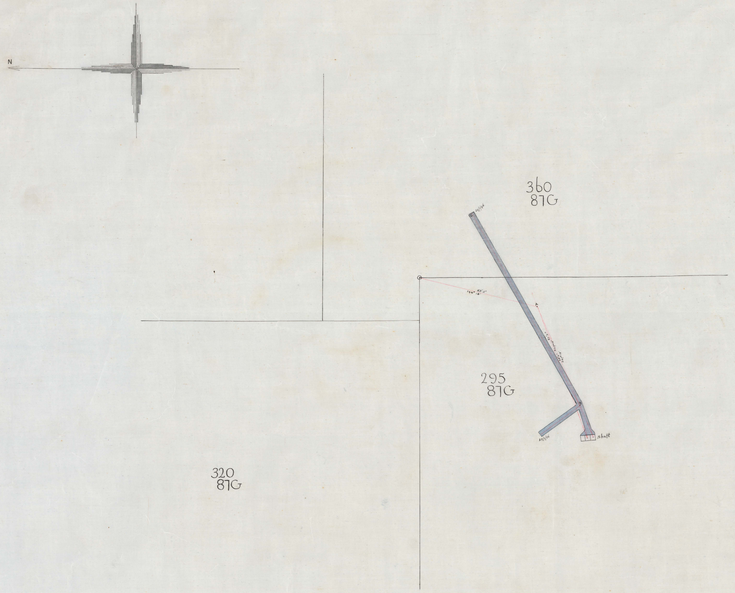

CROSS SECTION

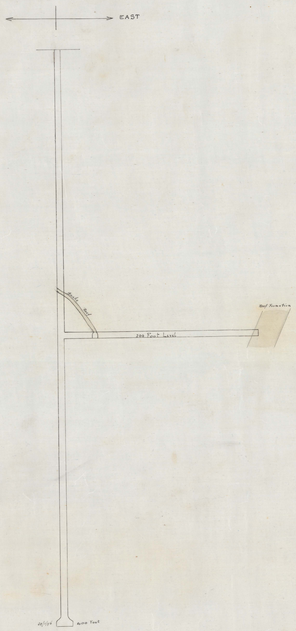

LONGITUDINAL SECTION

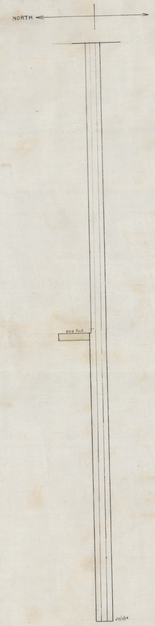

SCALE : 20 Feet = 1 Inch

Surveyed and drawn by Arthur Dickinson A.R.S.M.

Instrument Used Theodolite

20th March 1896