Longitudinal Section
Mining Work done from 17.3.96 to 21.1.97.

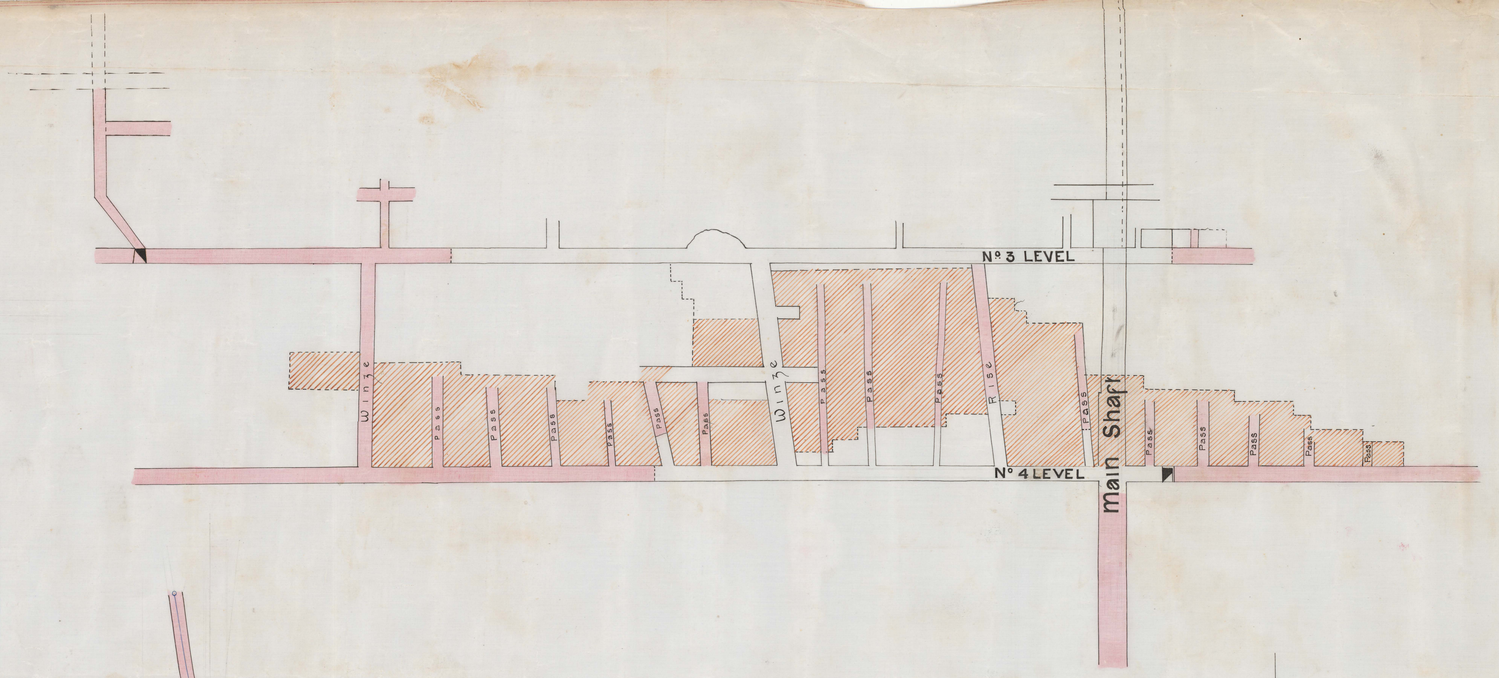


# PLAN

of

## Oonah Silver Mining Coy.s

Workings

Shewing Work done from 17.3.96 to 21.1.97

Scale 25 feet to 1 inch

Note:- Colored portions denote work done from 17.3.96. to 21.1.97.

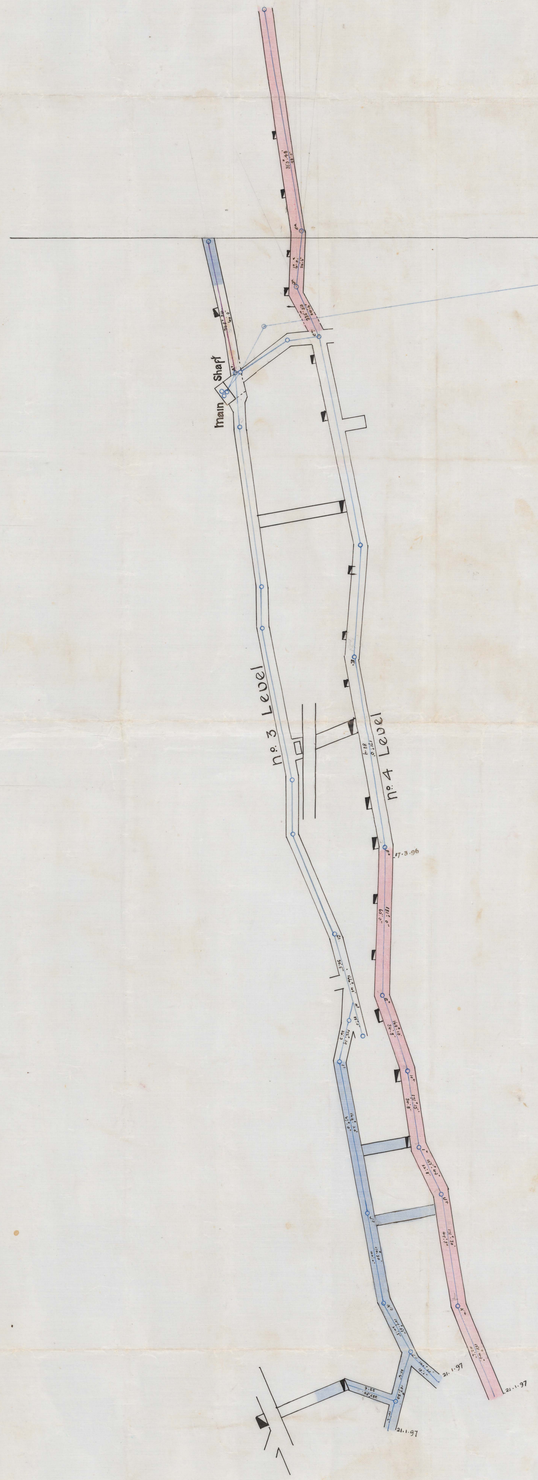

C. A. Hufenbaum
Mine Manager.
21.1.97.