230-08

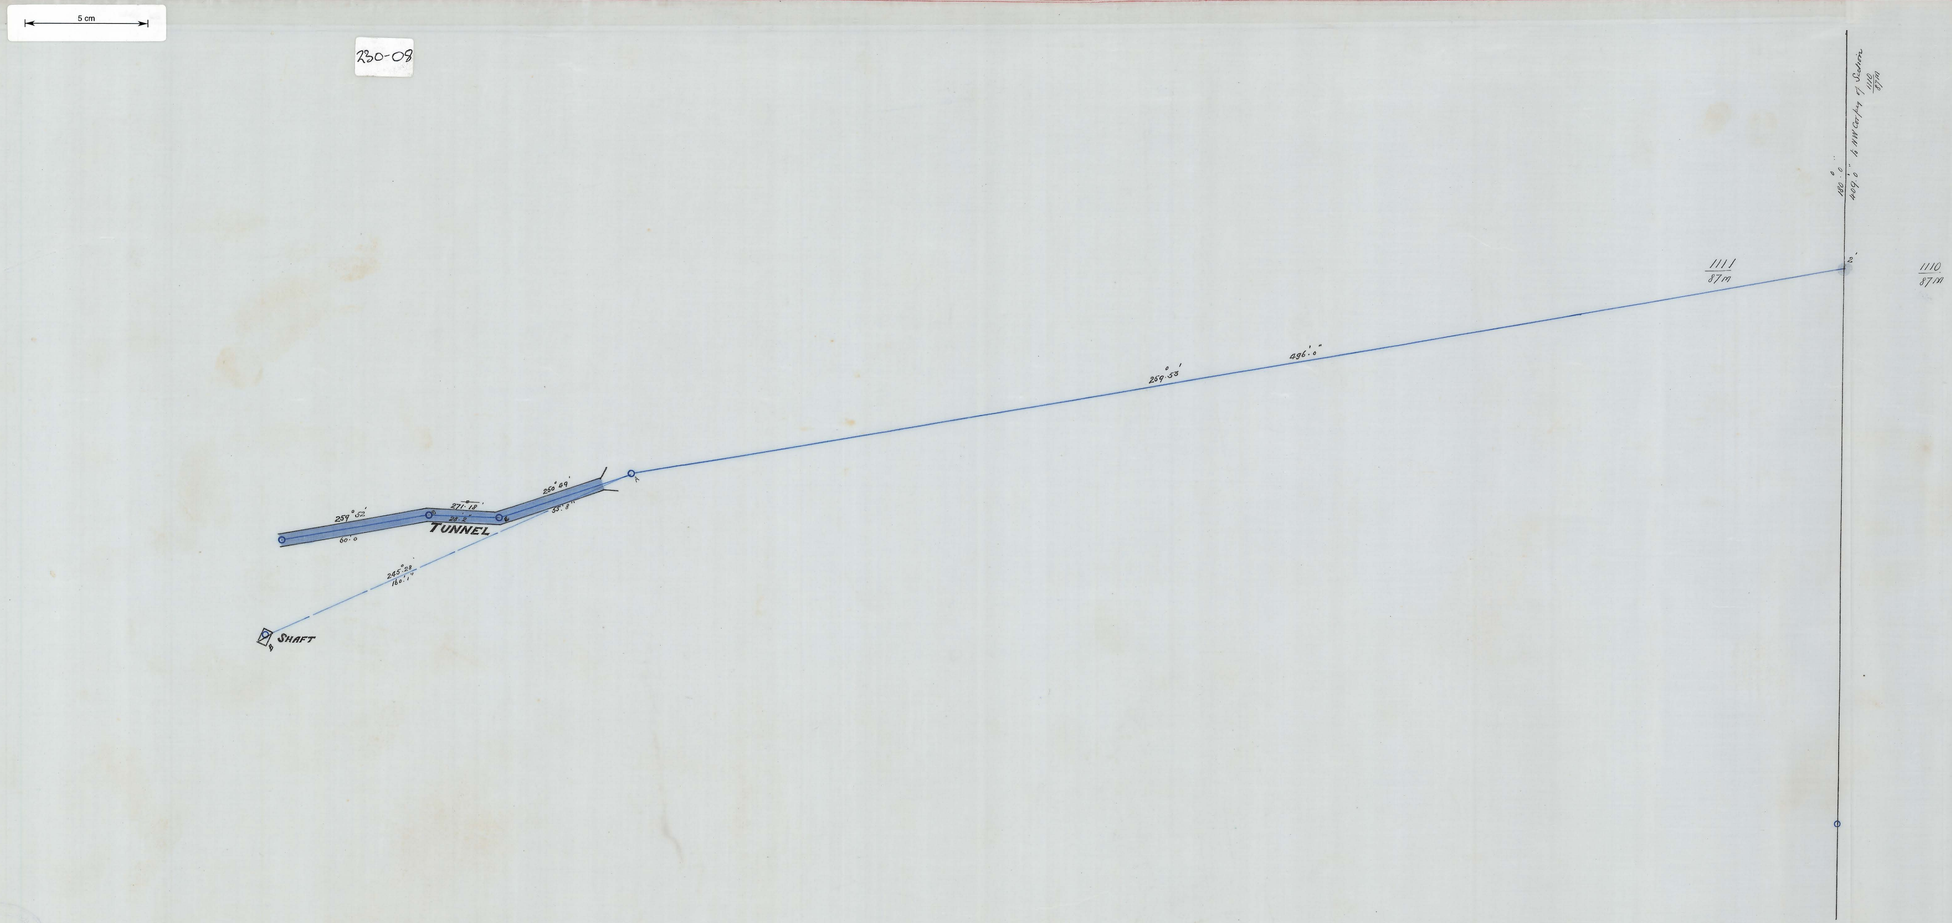

230-08

2 7 FEB 1899

1899