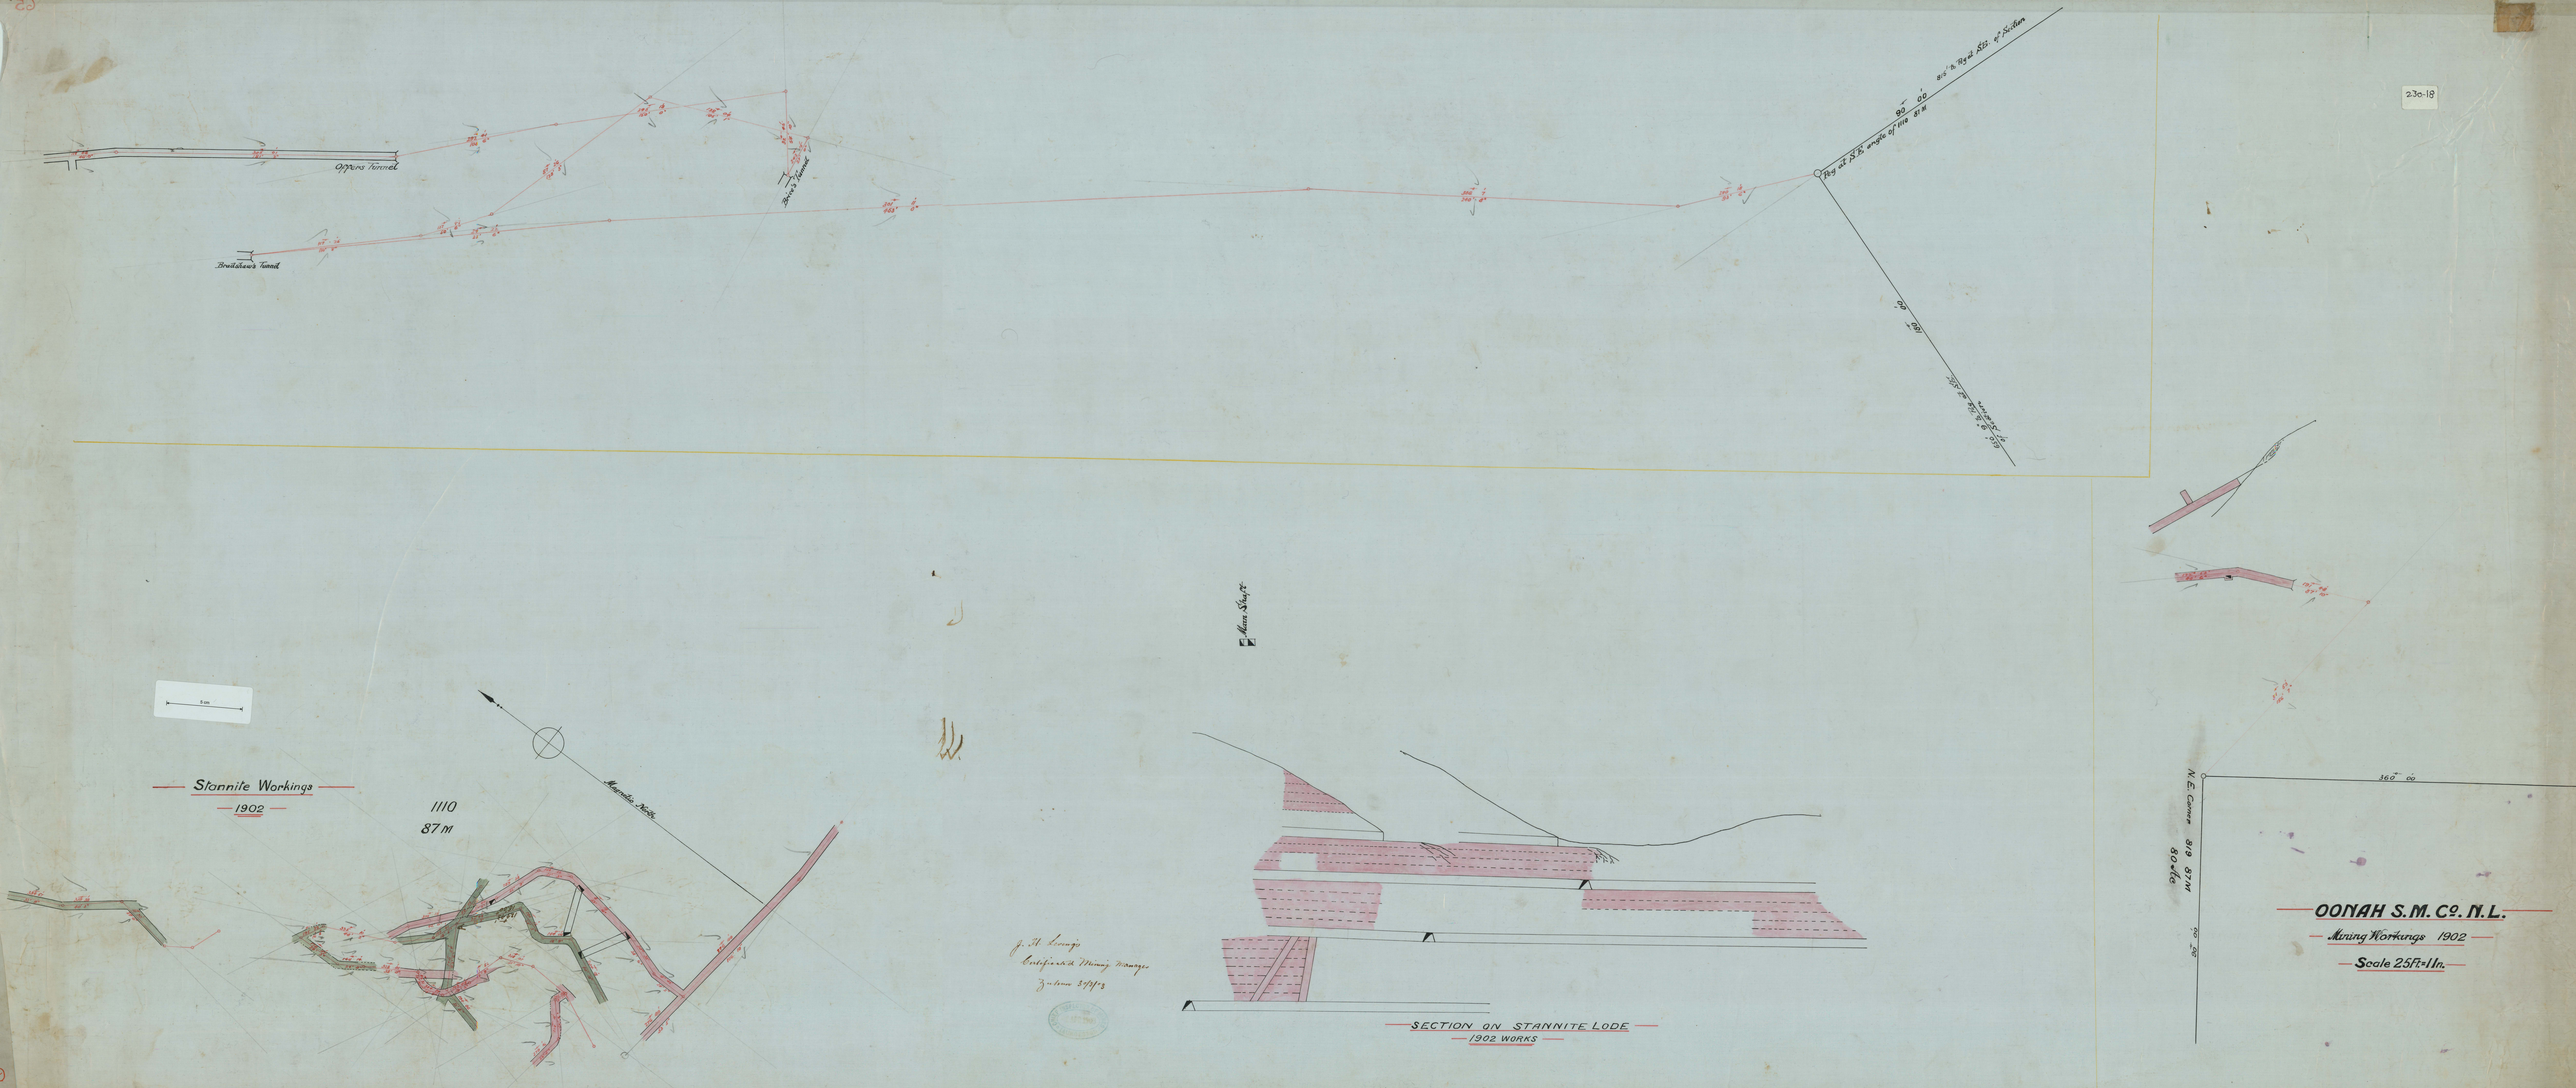
Oppins Tunnel
Brattshaws Tunnel
Bird's Tunnel
Peg at S.E. angle of the grant
Stannite Workings
1902
1110
87 m
Main Shaft
J. H. Livings
Certificated Mining Manager
Zeehan 27/11/03
SECTION ON STANNITE LODE
1902 WORKS
N.E. Corner
819 87 W
80 links
OONAH S.M. Co. N.L.
Mining Workings 1902
Scale 25Ft=1In.