

— OONAH MINE —


SECTION

ON LINE A-B

STANNITE

LODE

Scale 50 ft to an inch

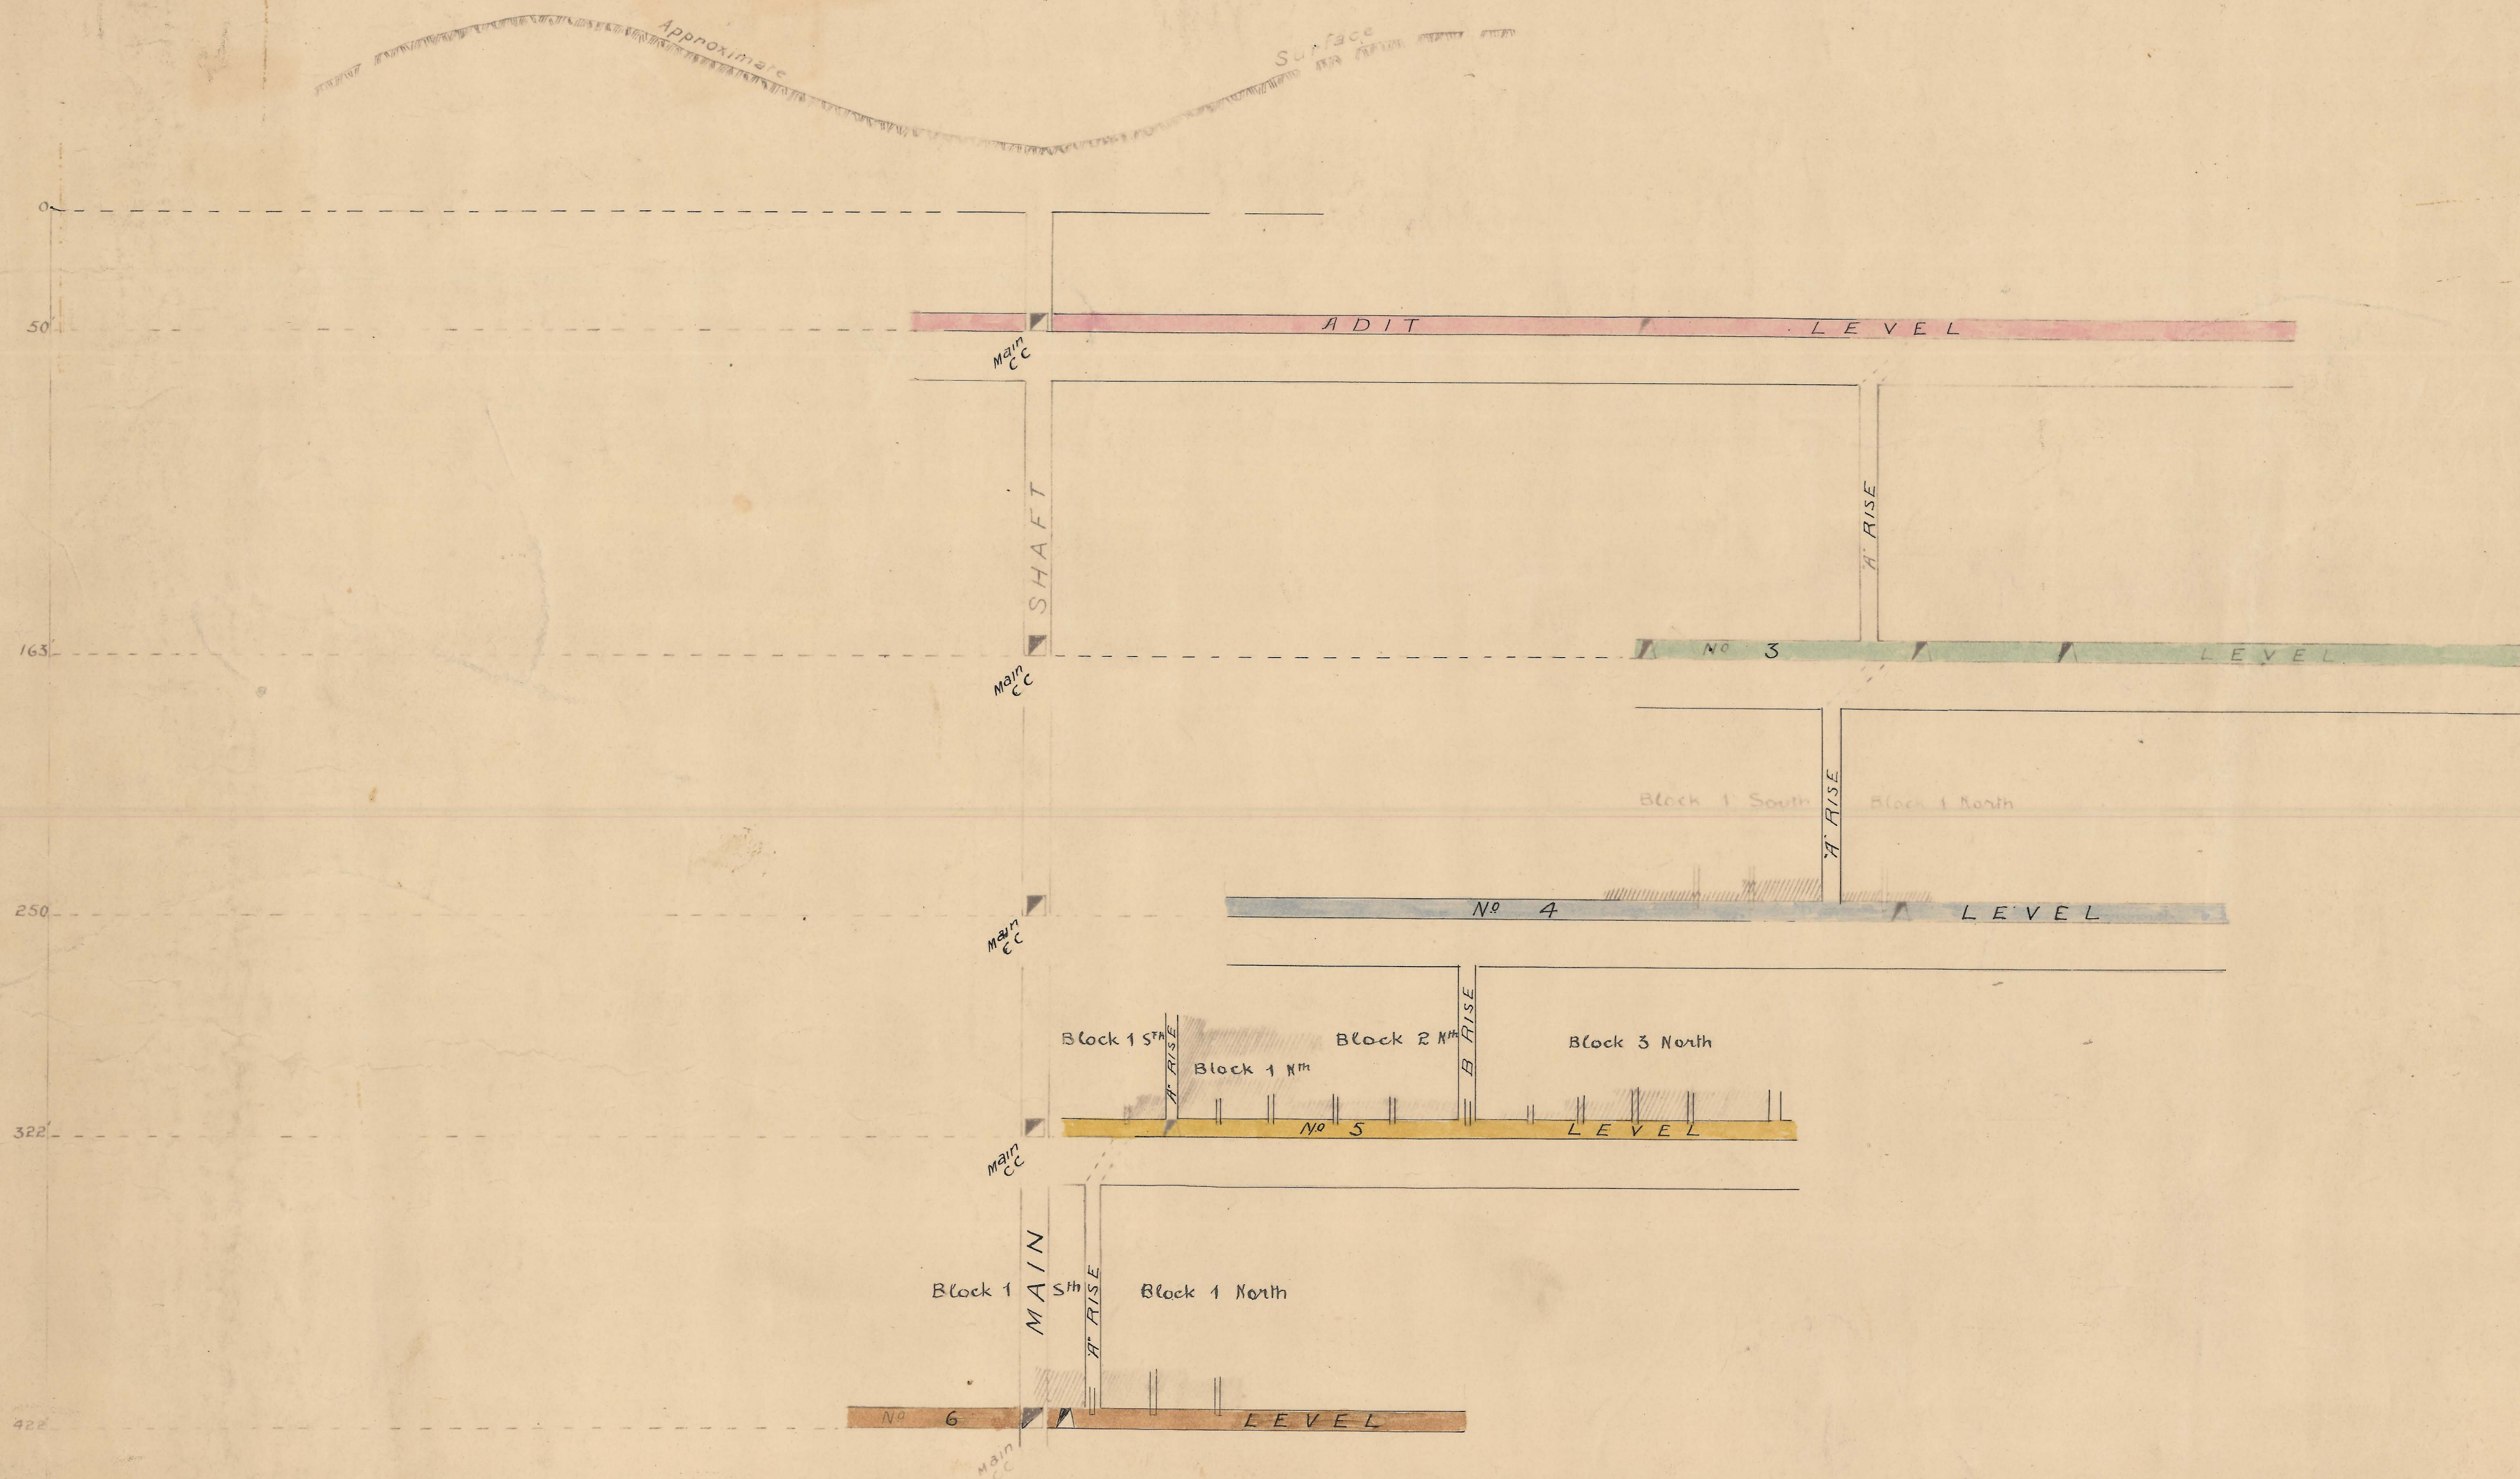

See Aug 92