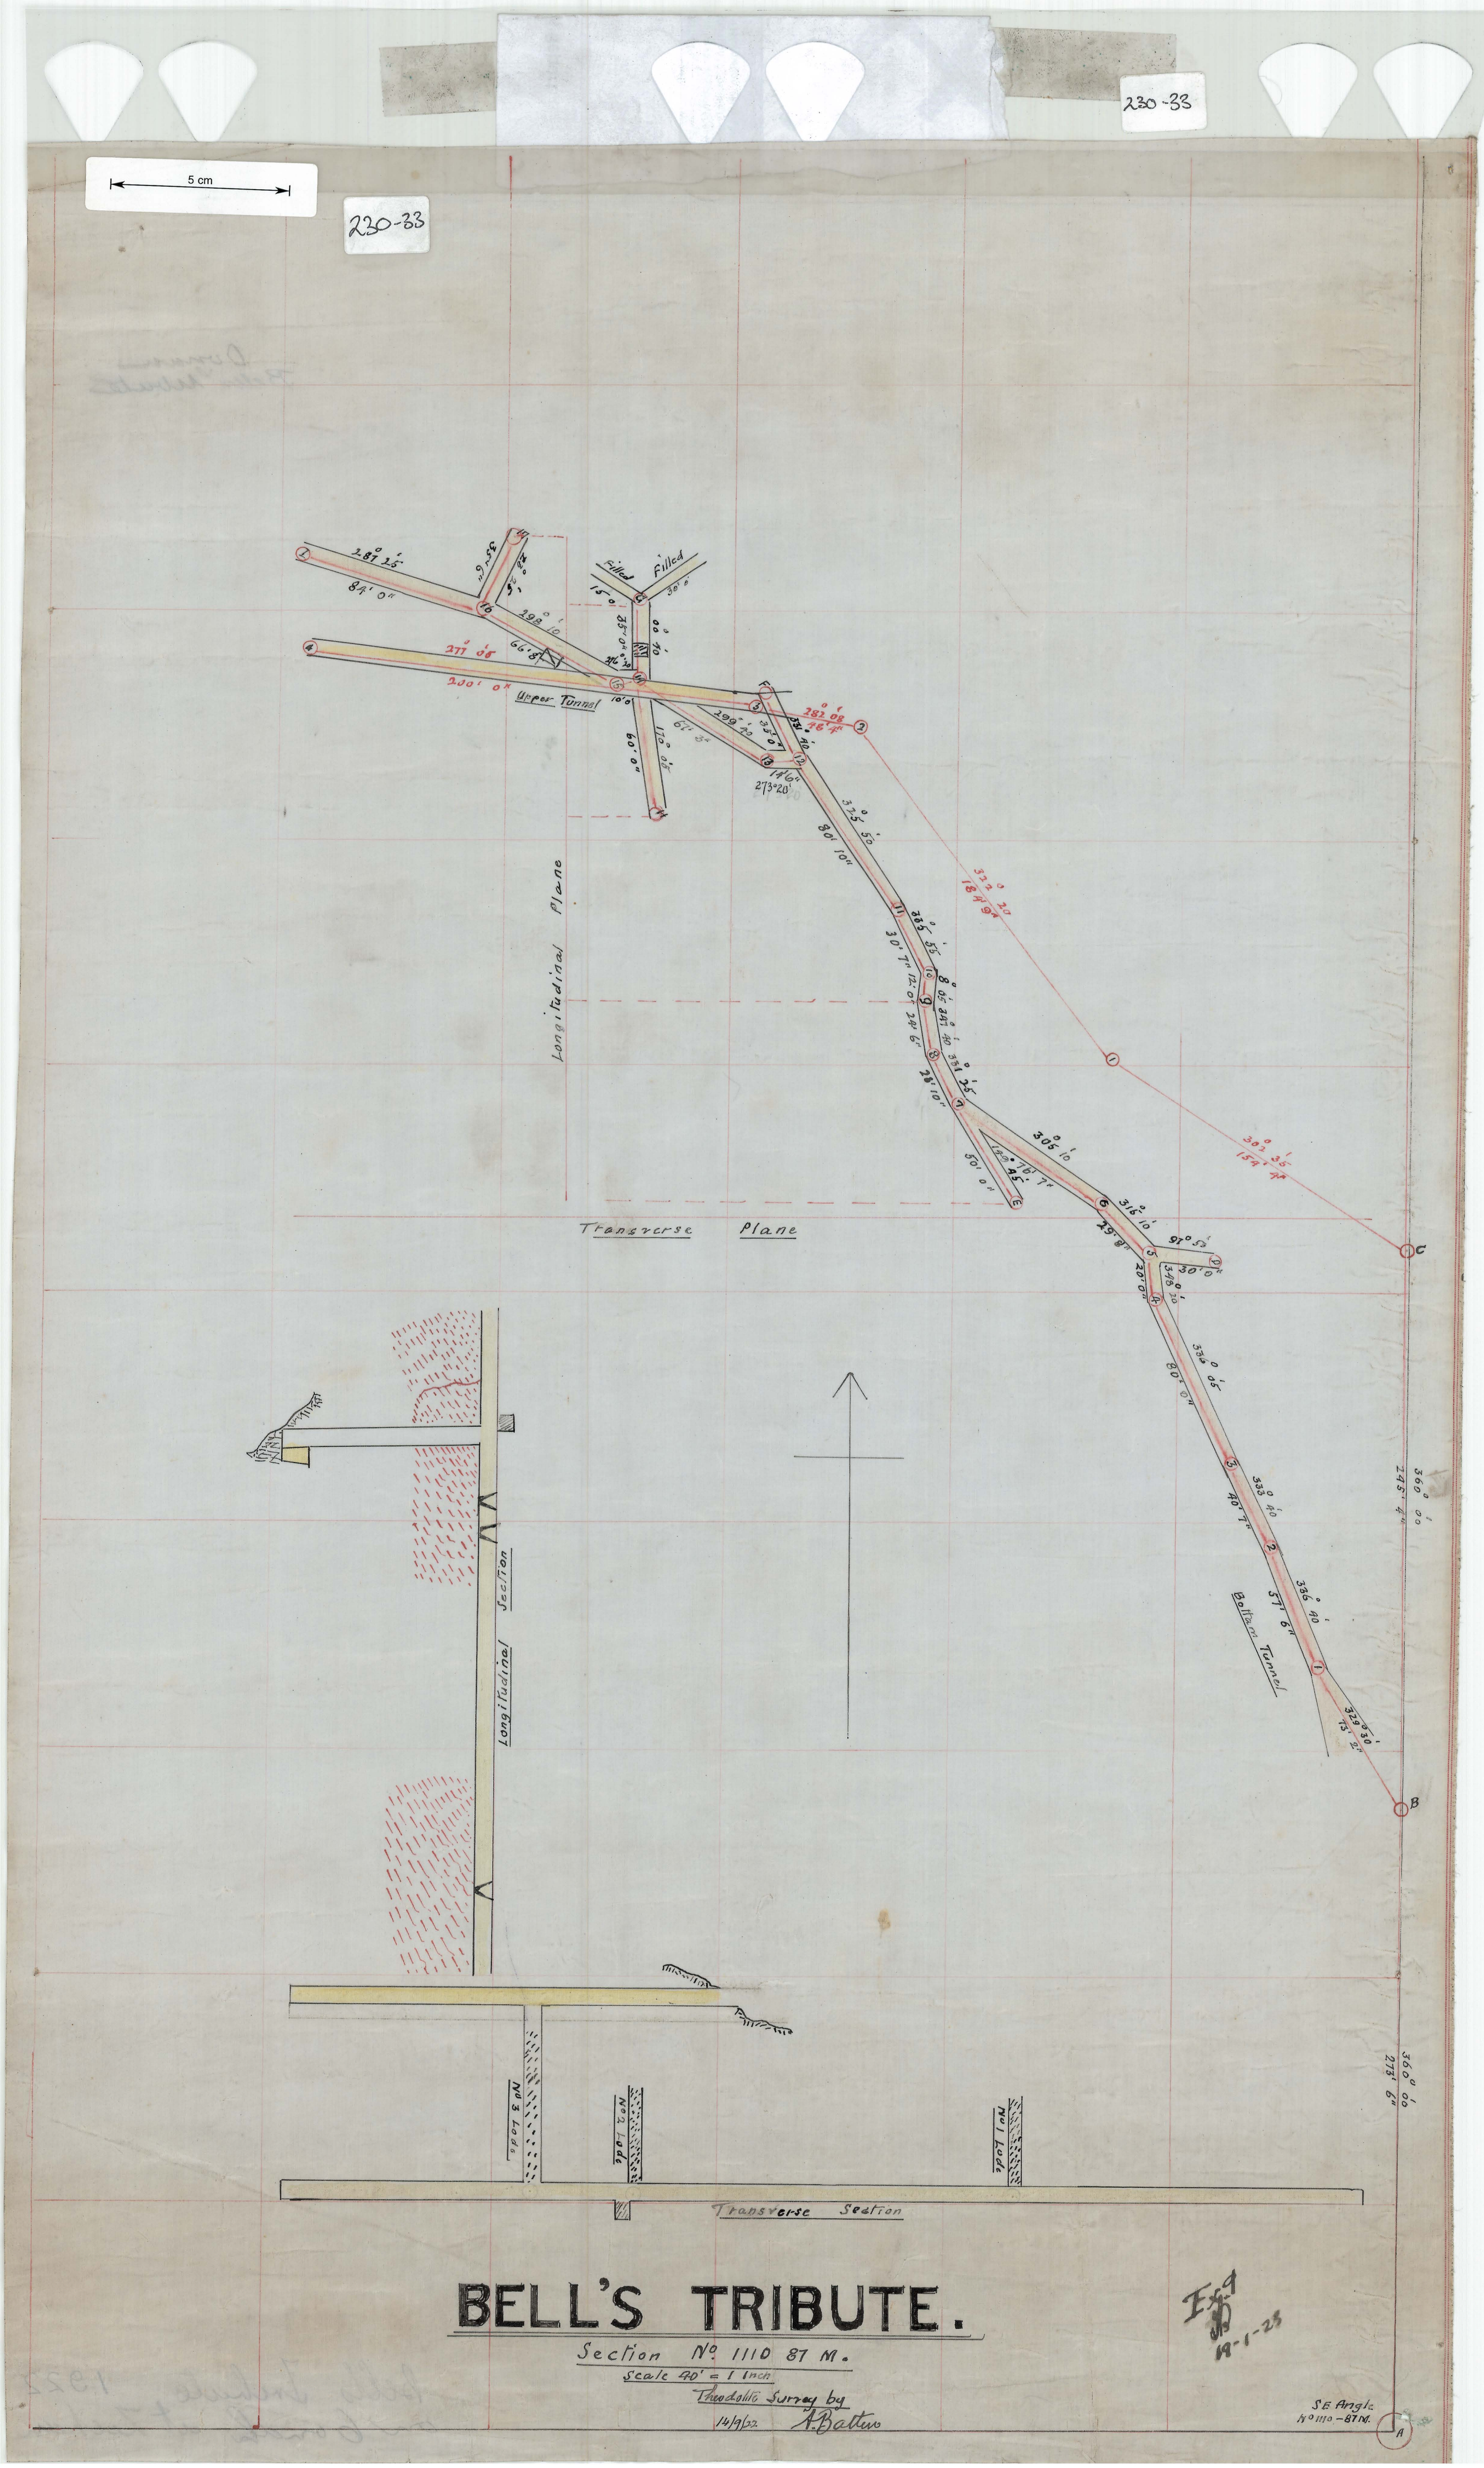
5 cm
230-33
230-33
Upper Tunnel
Longitudinal Plane
Transverse Plane
Longitudinal Section
Bottom Tunnel
No 3 Lode
No 2 Lode
No 1 Lode
Transverse Section
BELL'S TRIBUTE.
Section No 1110 87 M.
Scale 40' = 1 inch
Theodolite Survey by
14/9/22 A. Batten
Exd
19-1-23
S.E. Angle
No 1110 - 87 M.
A