

819
87M
80 AC


819
87M
80 AC

— OONAH MINES LIMITED —

PLAN


— Scale 50 ft to an Inch —

5 cm
0230-036

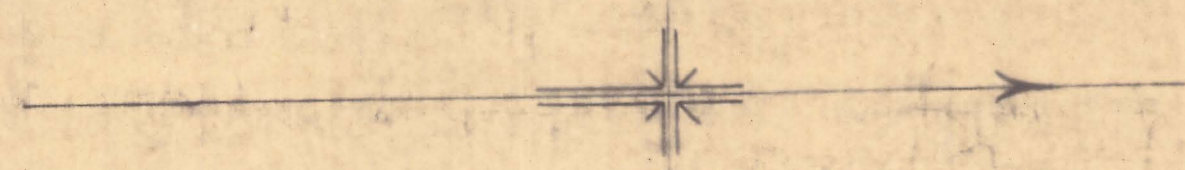

819
87M

80 AC.

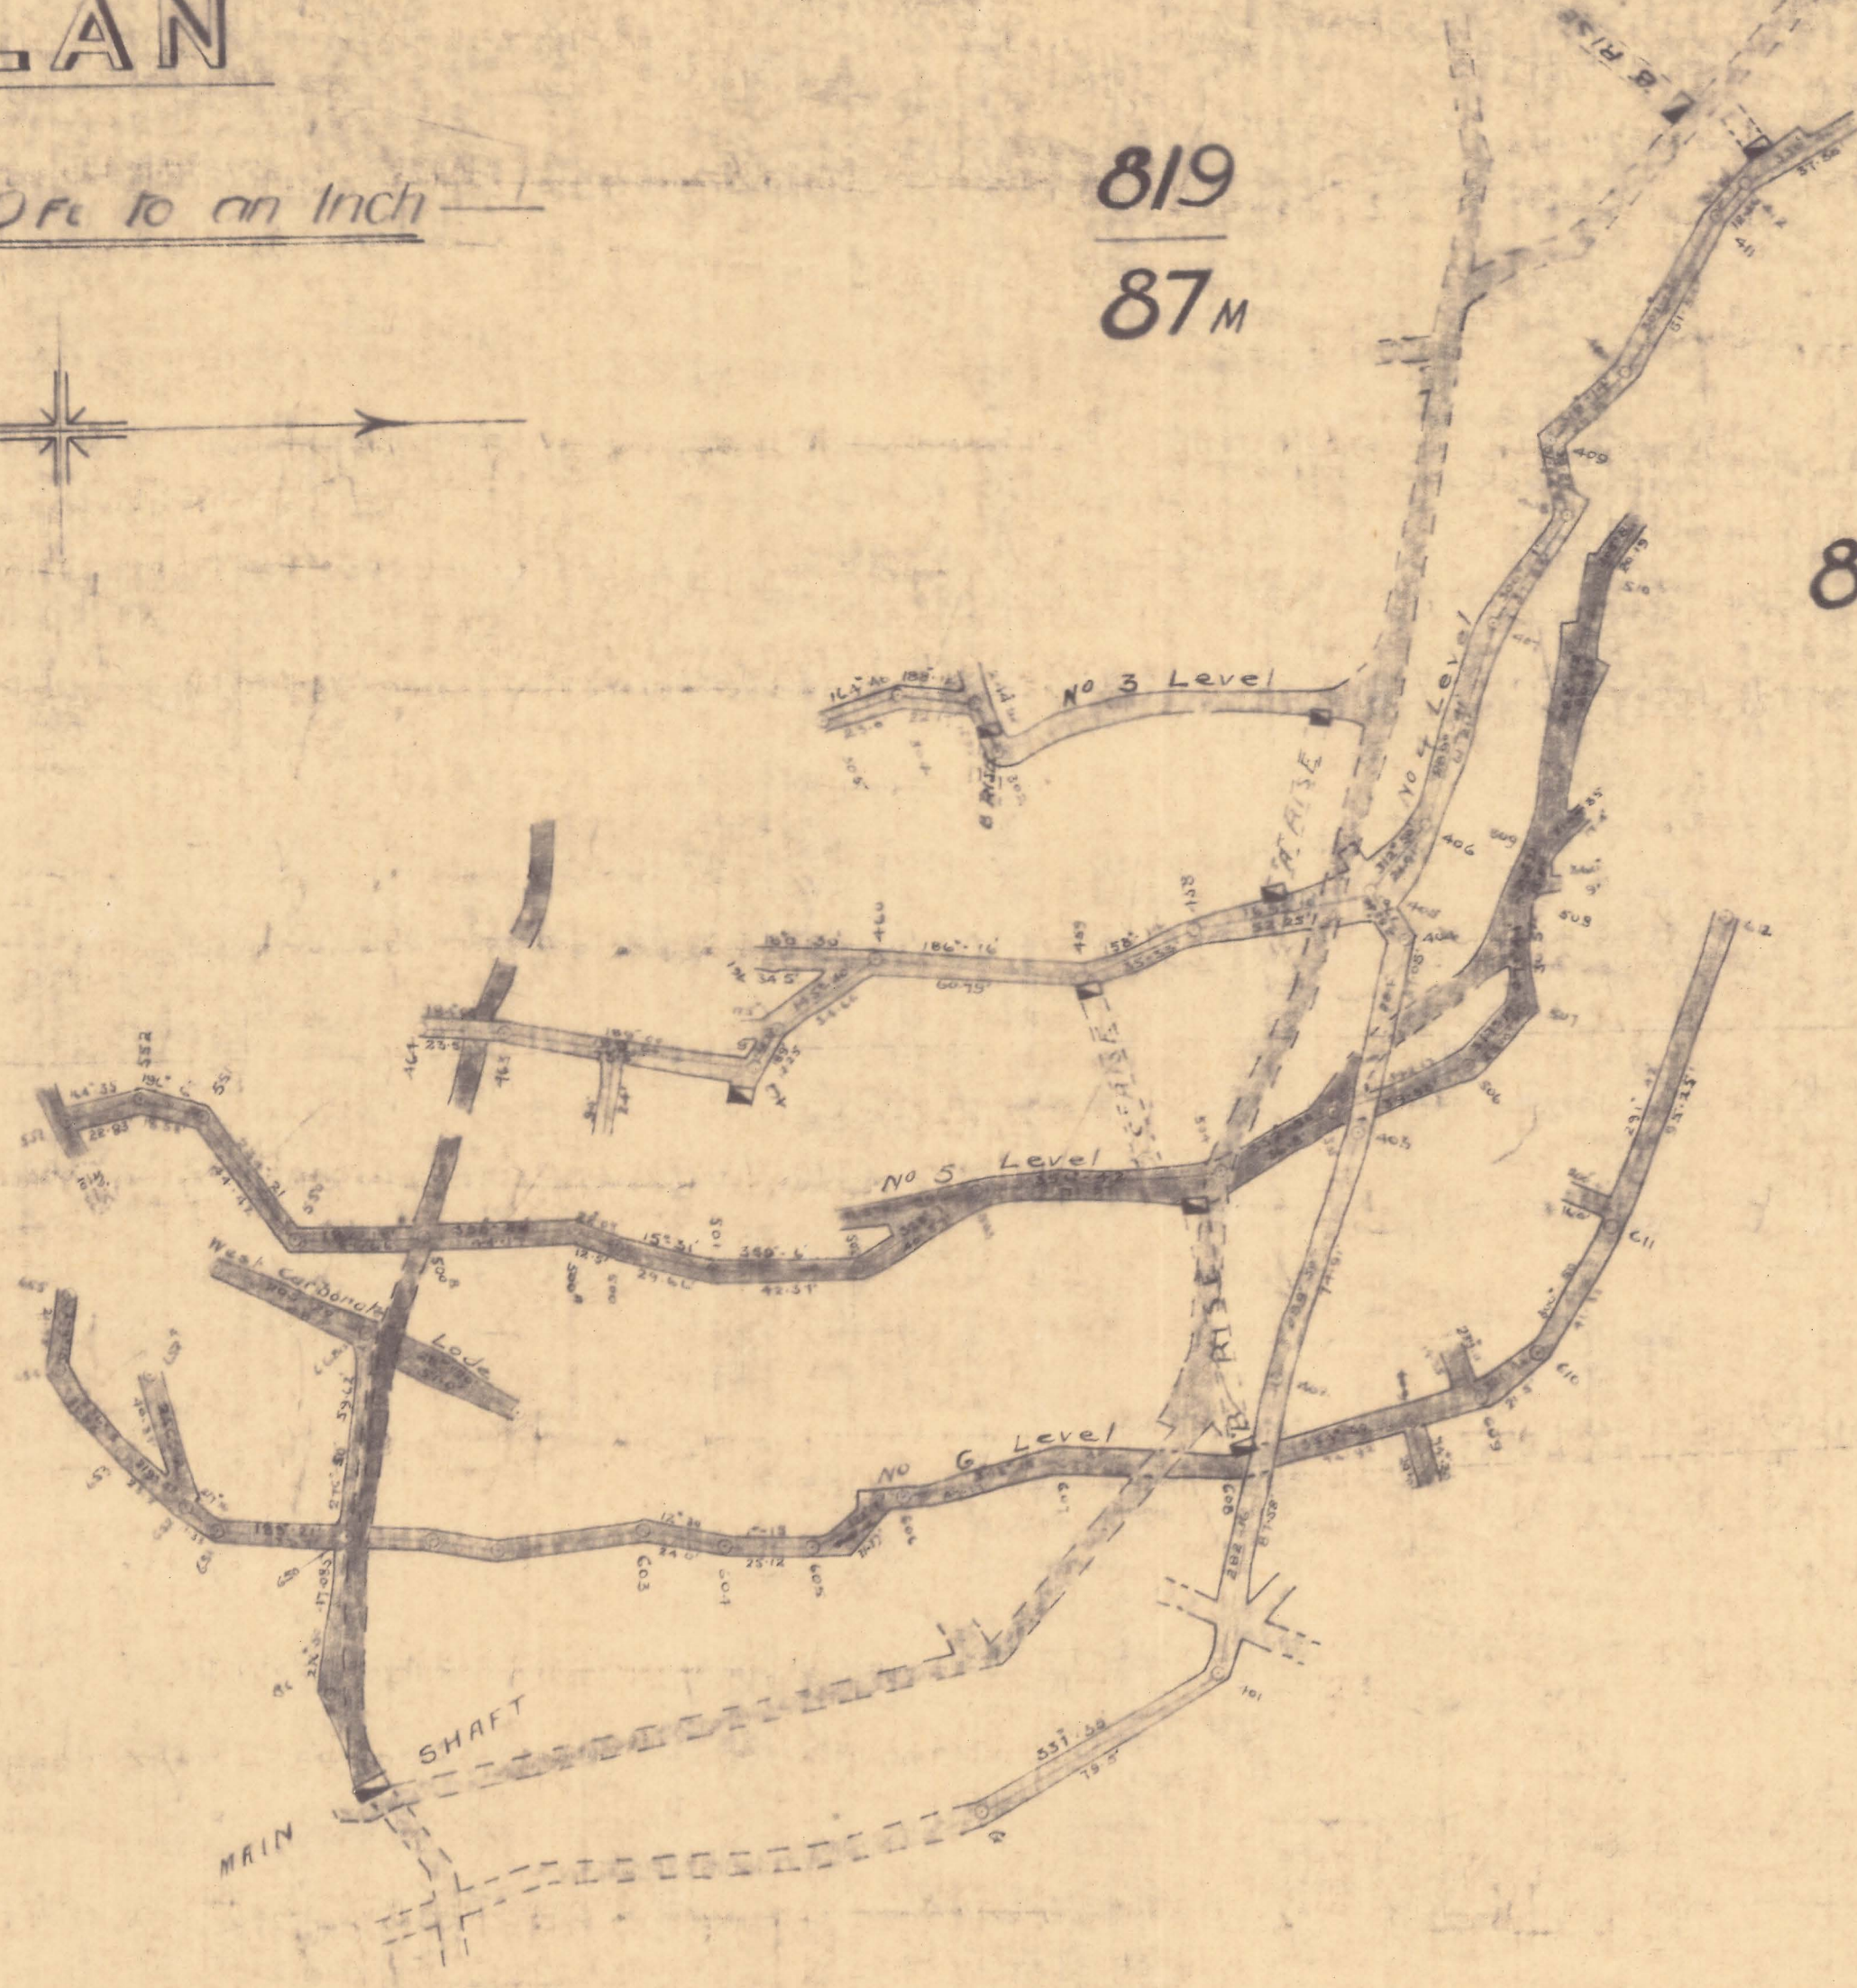

W. C. Roddall,
Mine Manager
21st Dec 1910.