
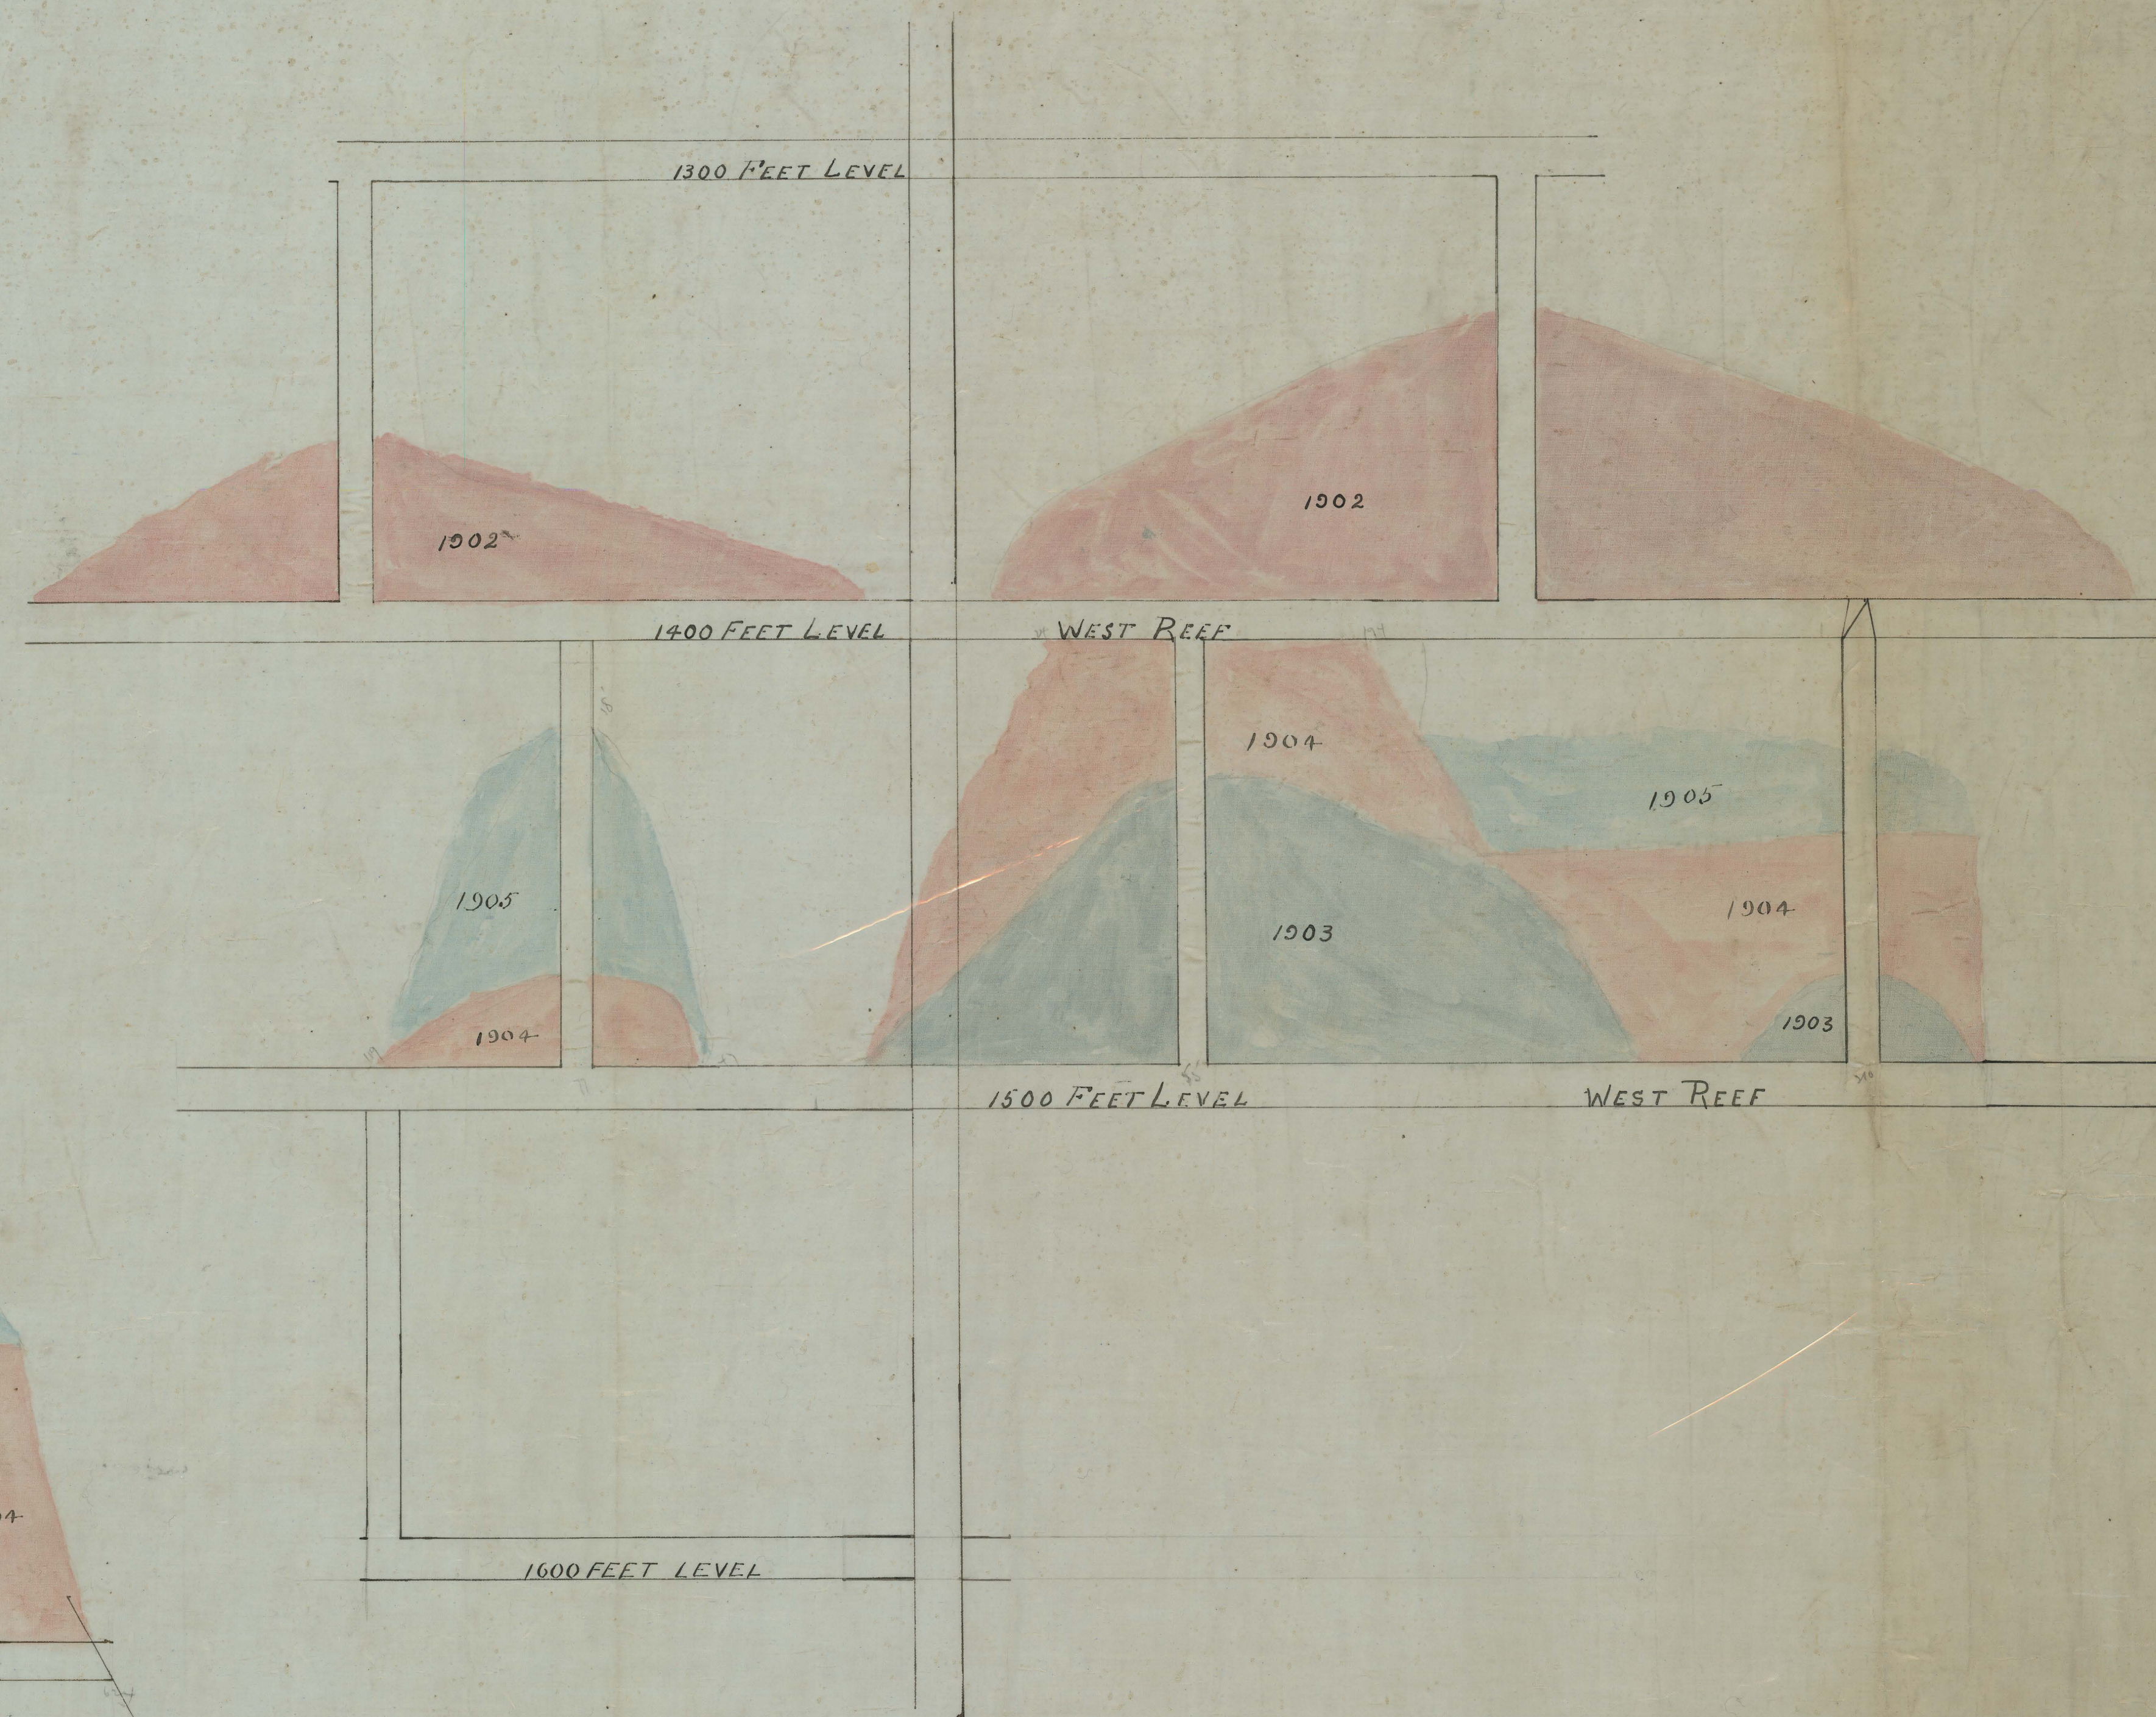


LONGITUDINAL SECTION

Scale 25 Feet to one inch

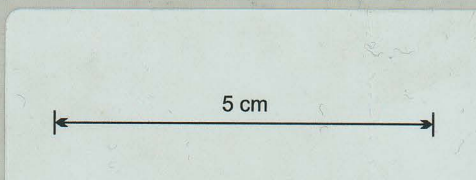

JAN 1 1904

JAN 1906

531-05

231/024