


LONGITUDINAL SECTION  
MAIN REEF

Scale: - 25 Feet to one inch

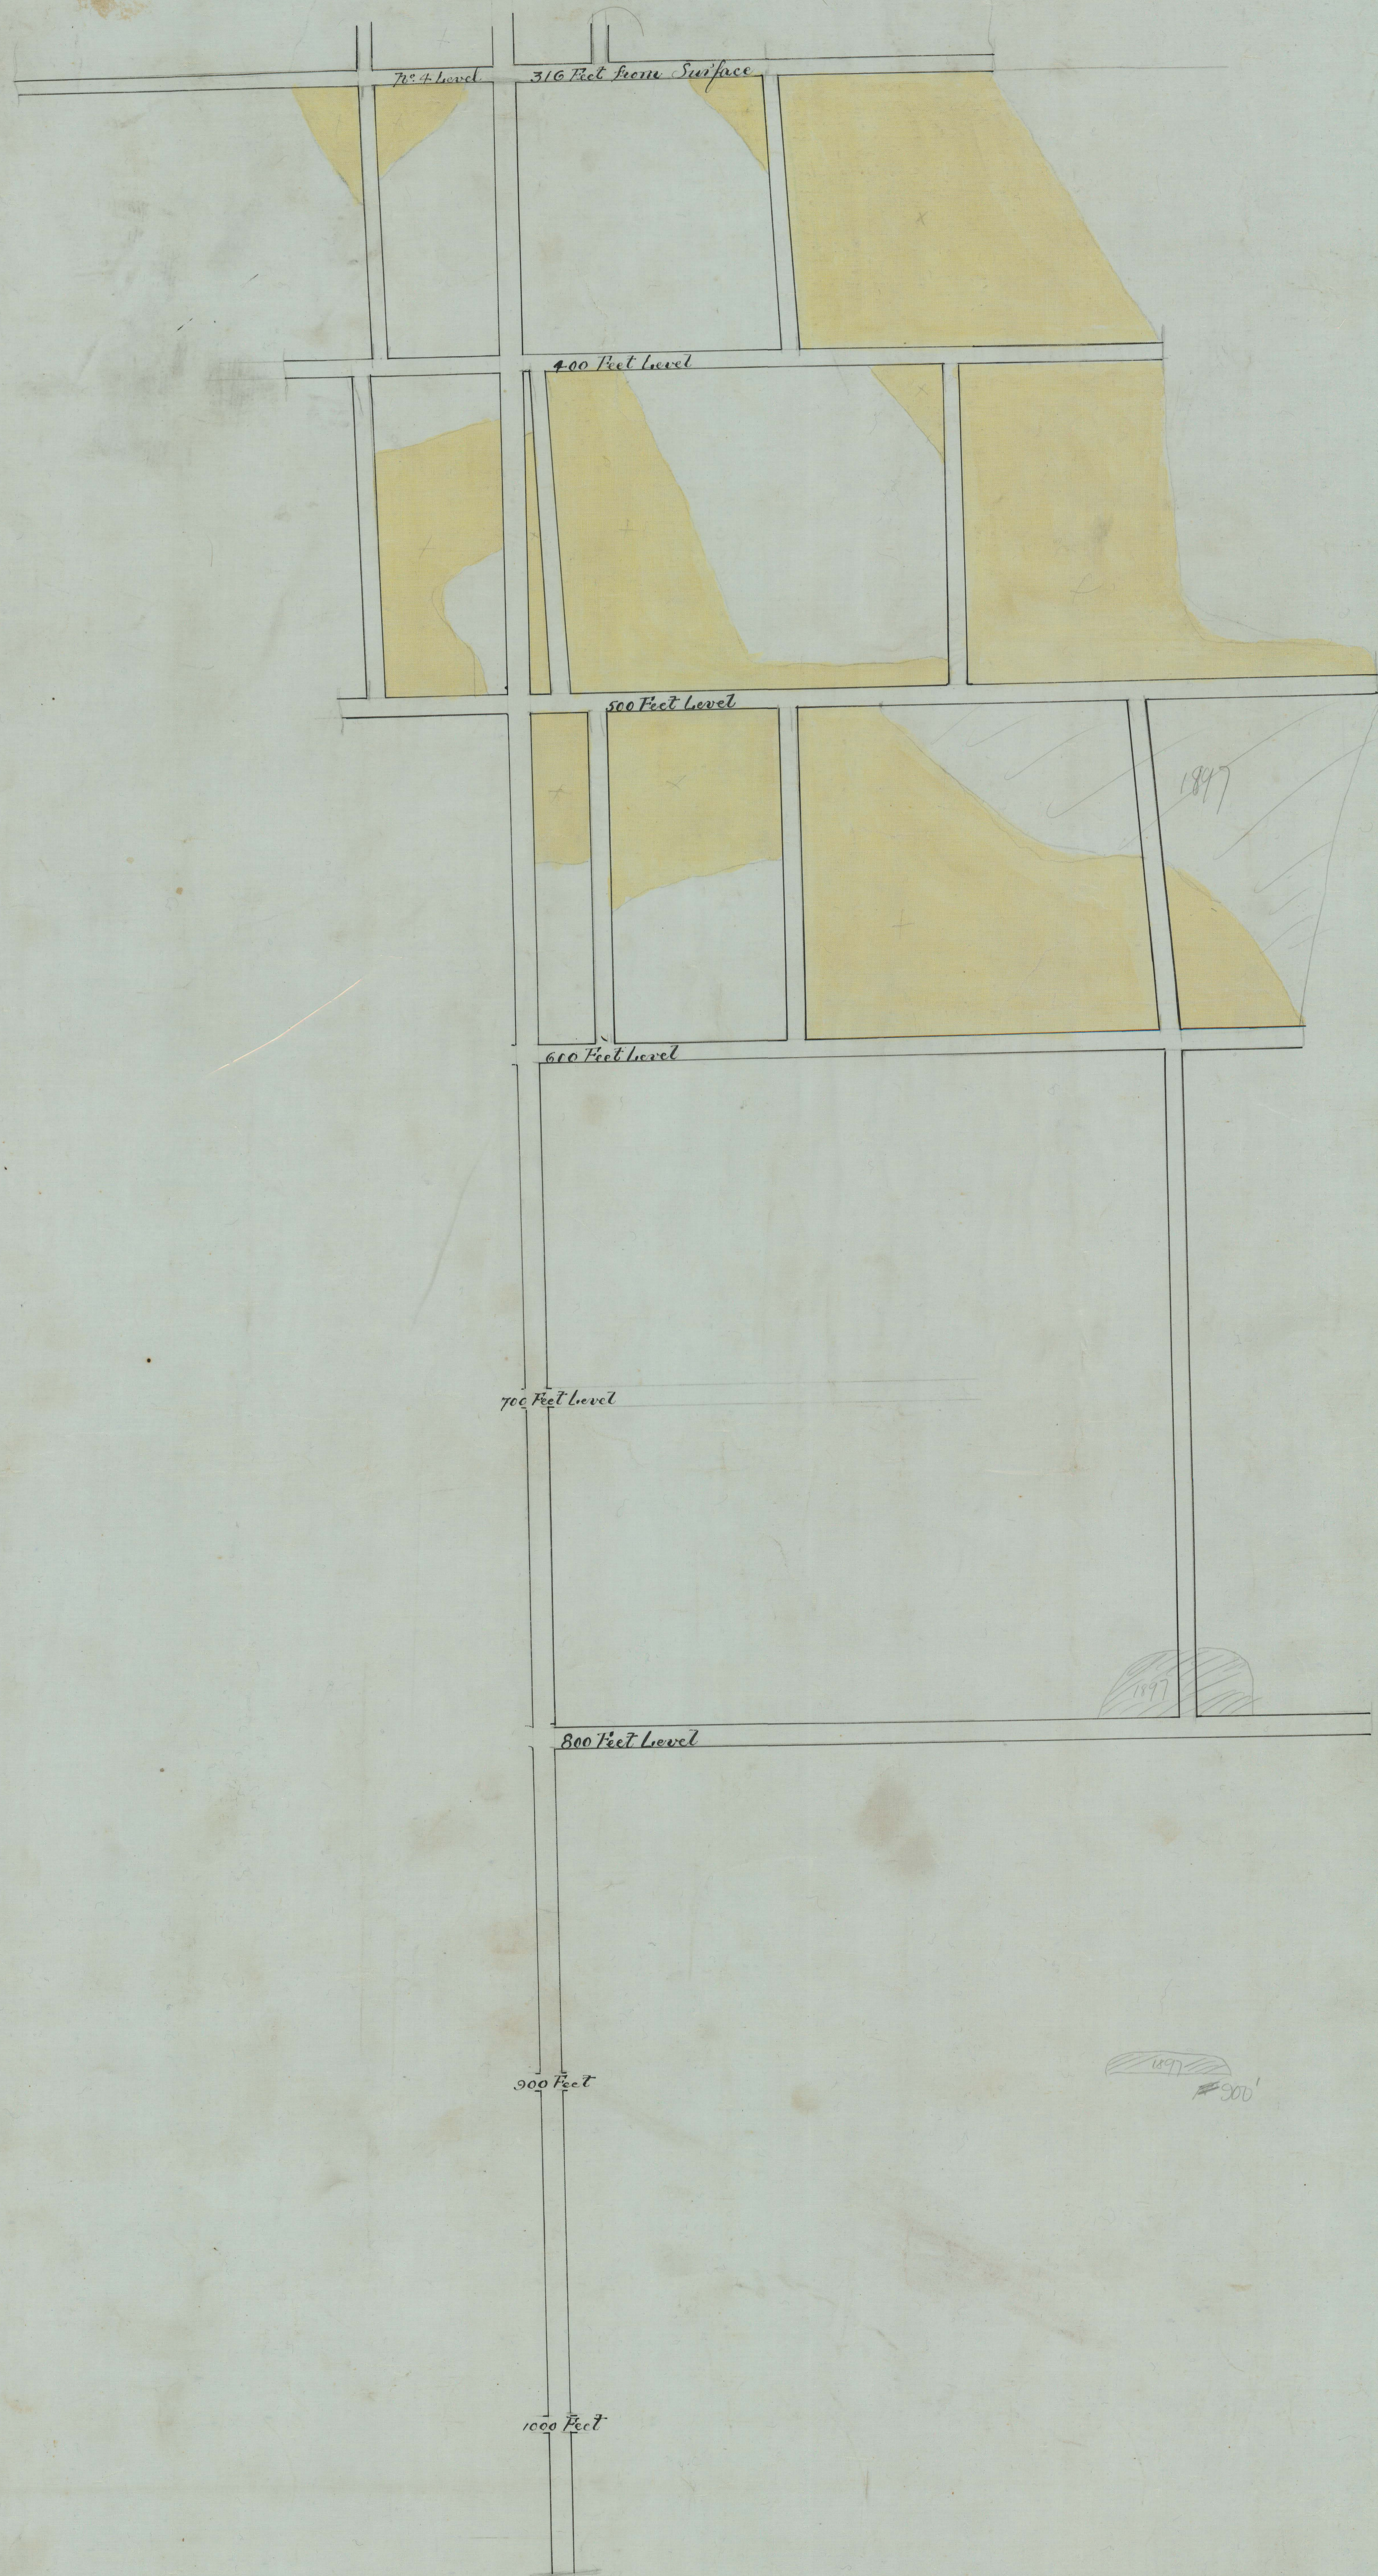

LONGITUDINAL SECTION  
LOANES REEF

Scale: - 25 Feet to one inch

