


23/10/83

M C^o


LONGTITUDINAL SECTION

LOANES REEF

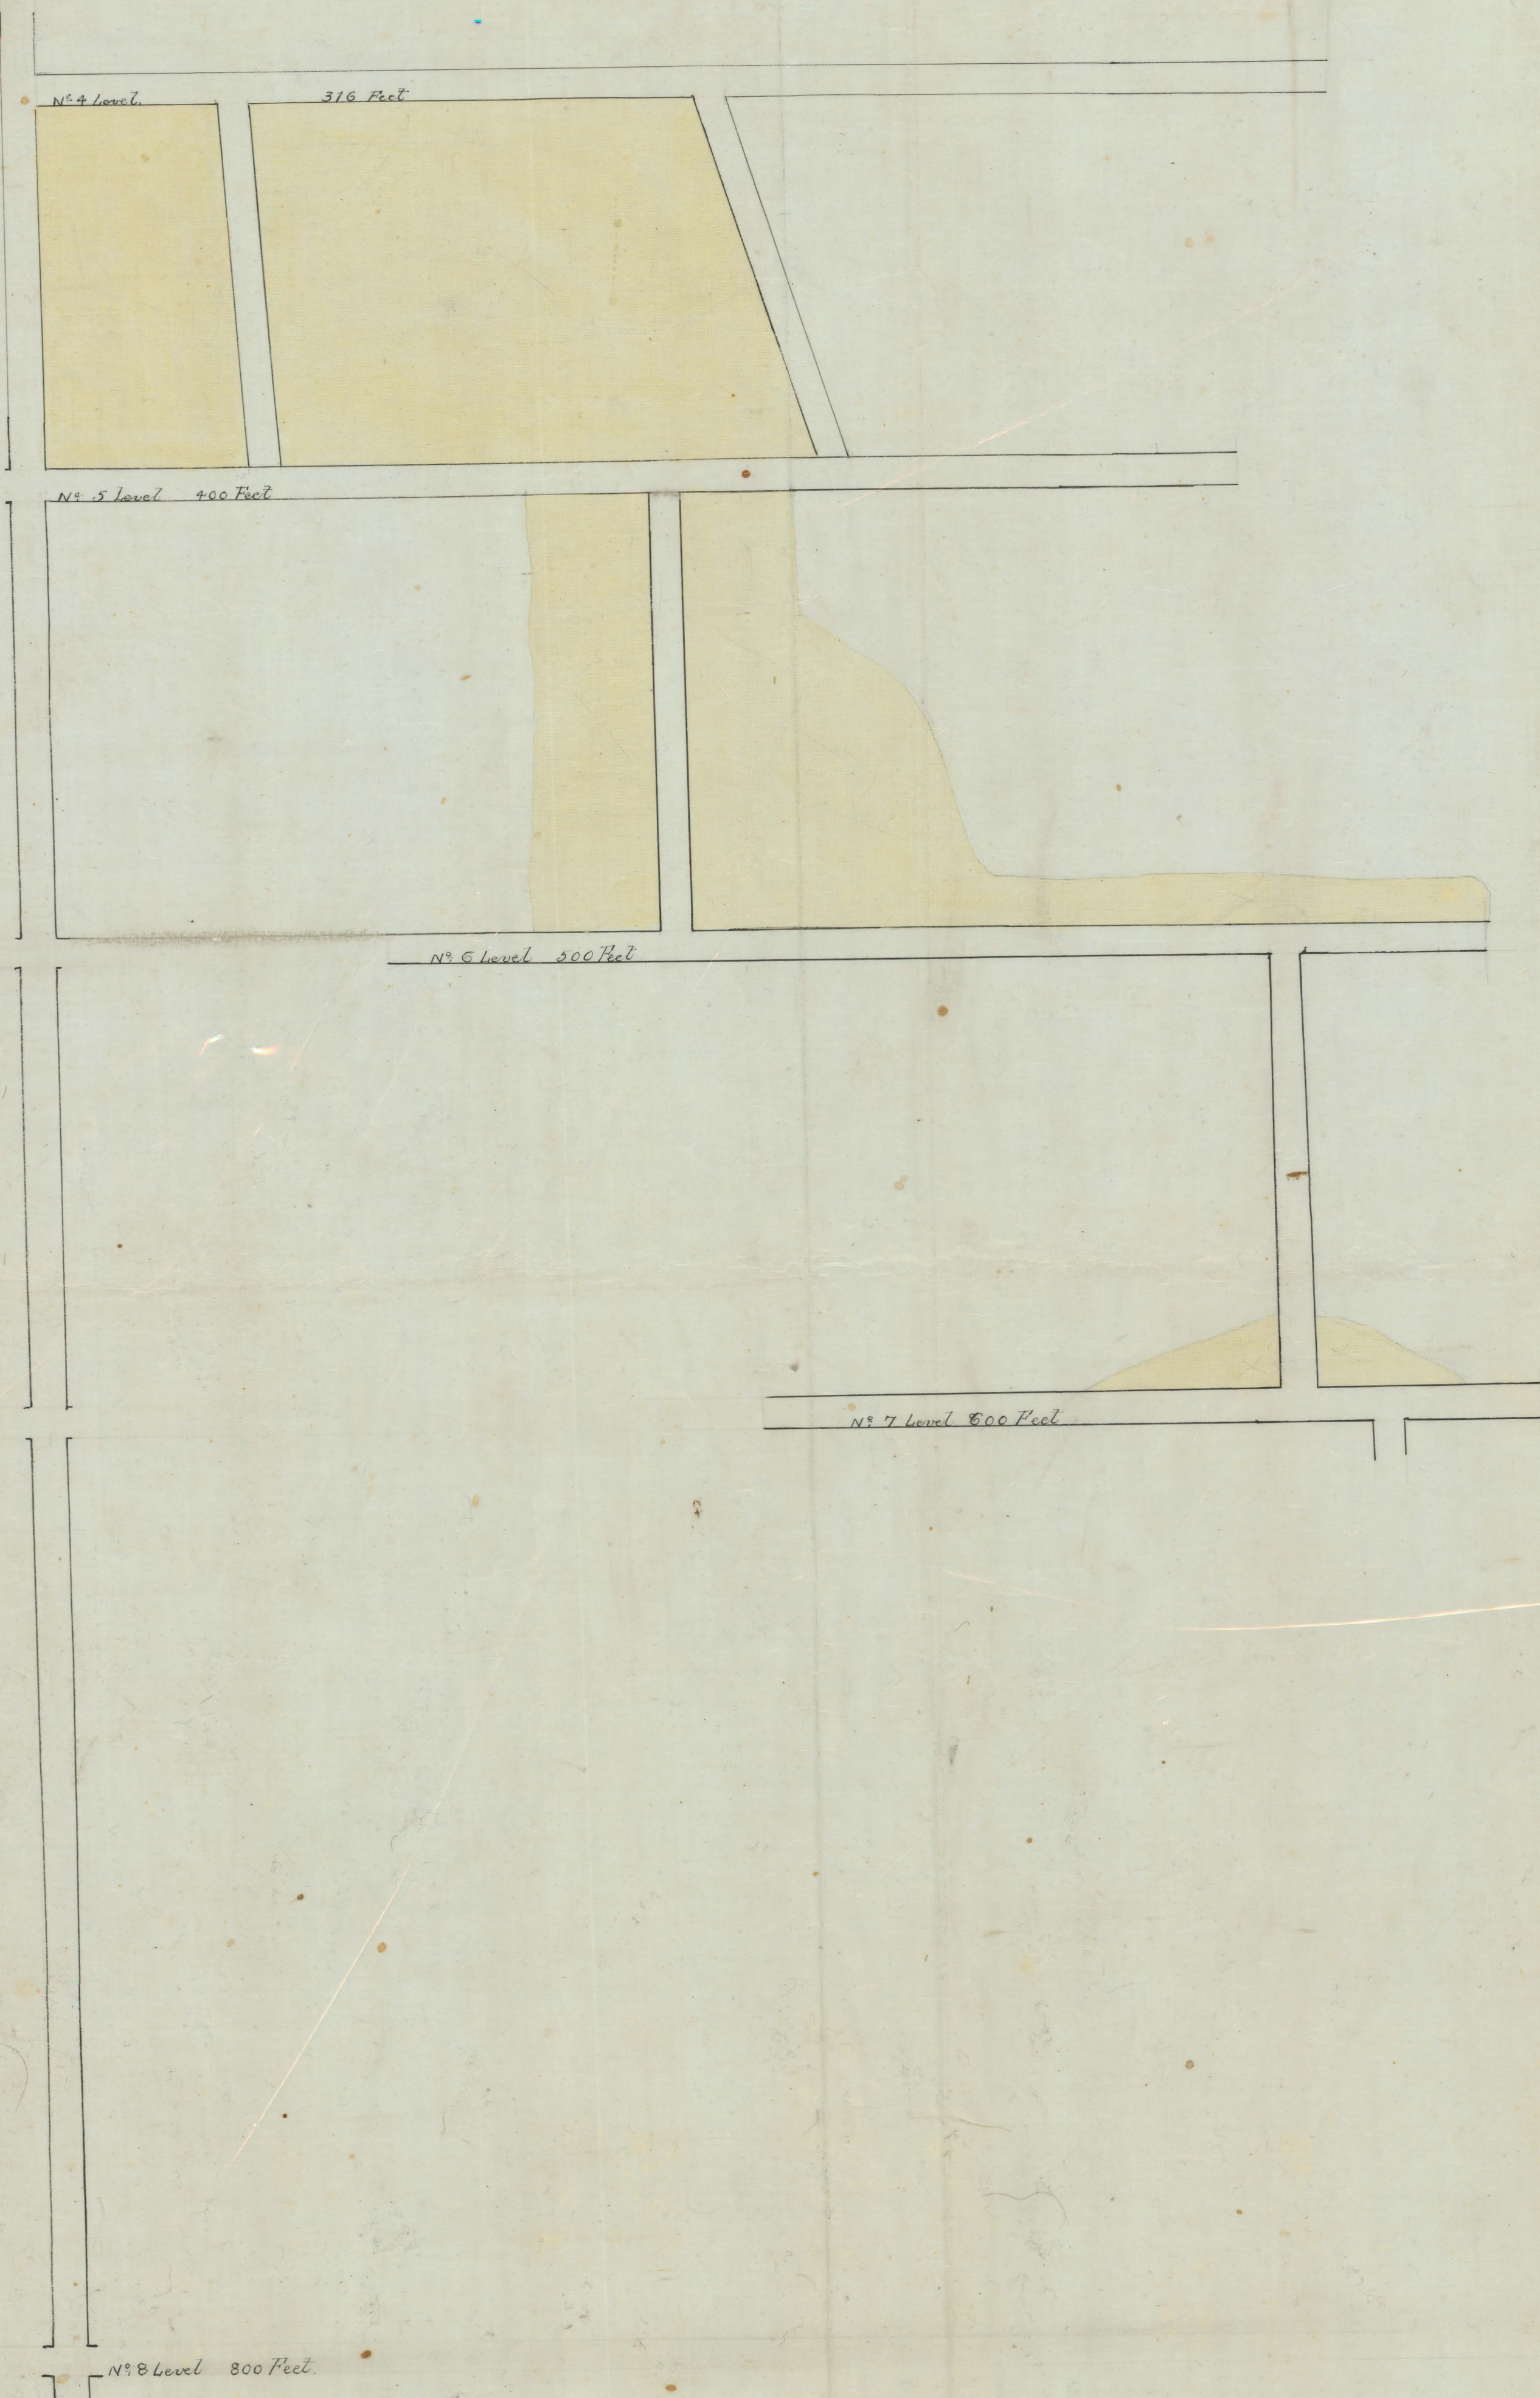

LONGTITUDINAL SECTION

MAIN REEF

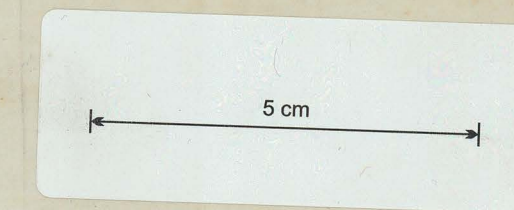

24
New Golden Gate
1895