LONGITUDINAL SECTIONS

Scale: 25 Feet to one inch

5 cm

LOANES REEF

23-05

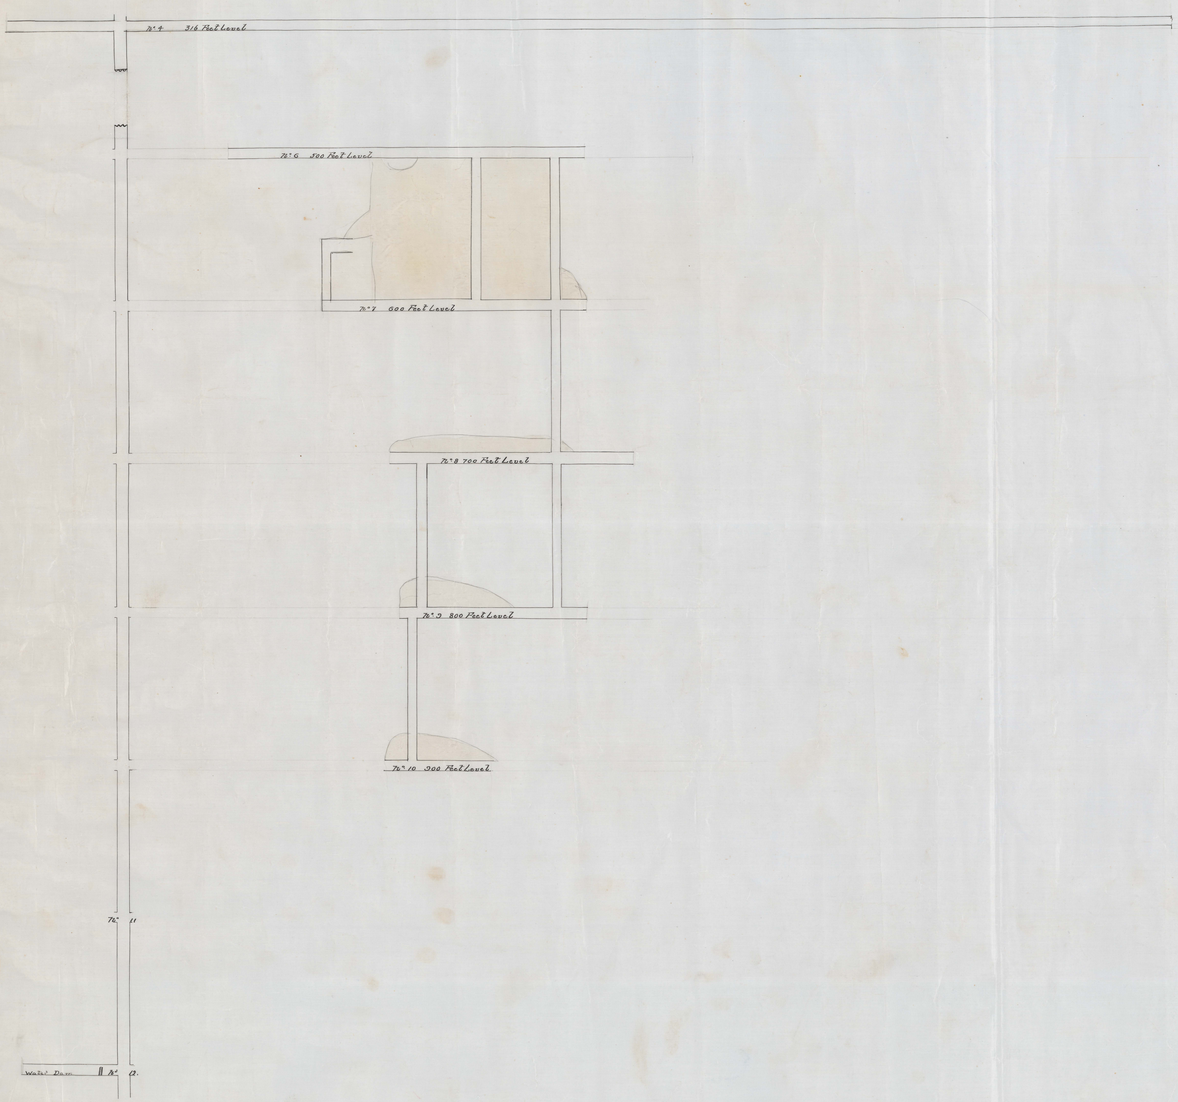

MAIN REEF

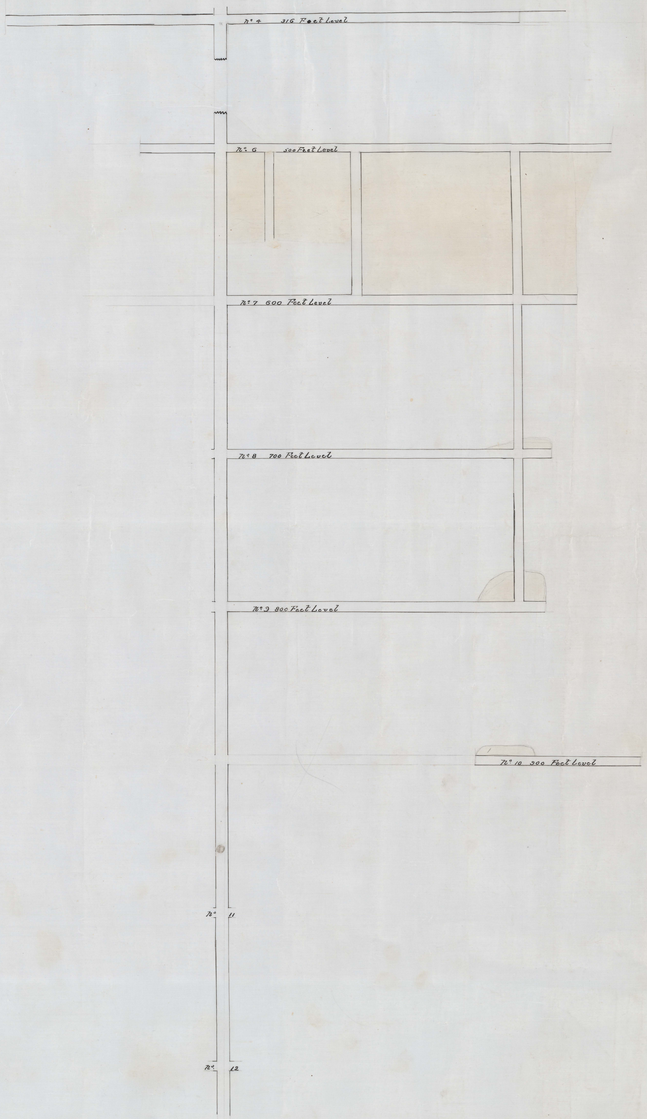

Certified to be a true Longitudinal Section of the Mine

MINERALS & ENERGY LIBRARY