
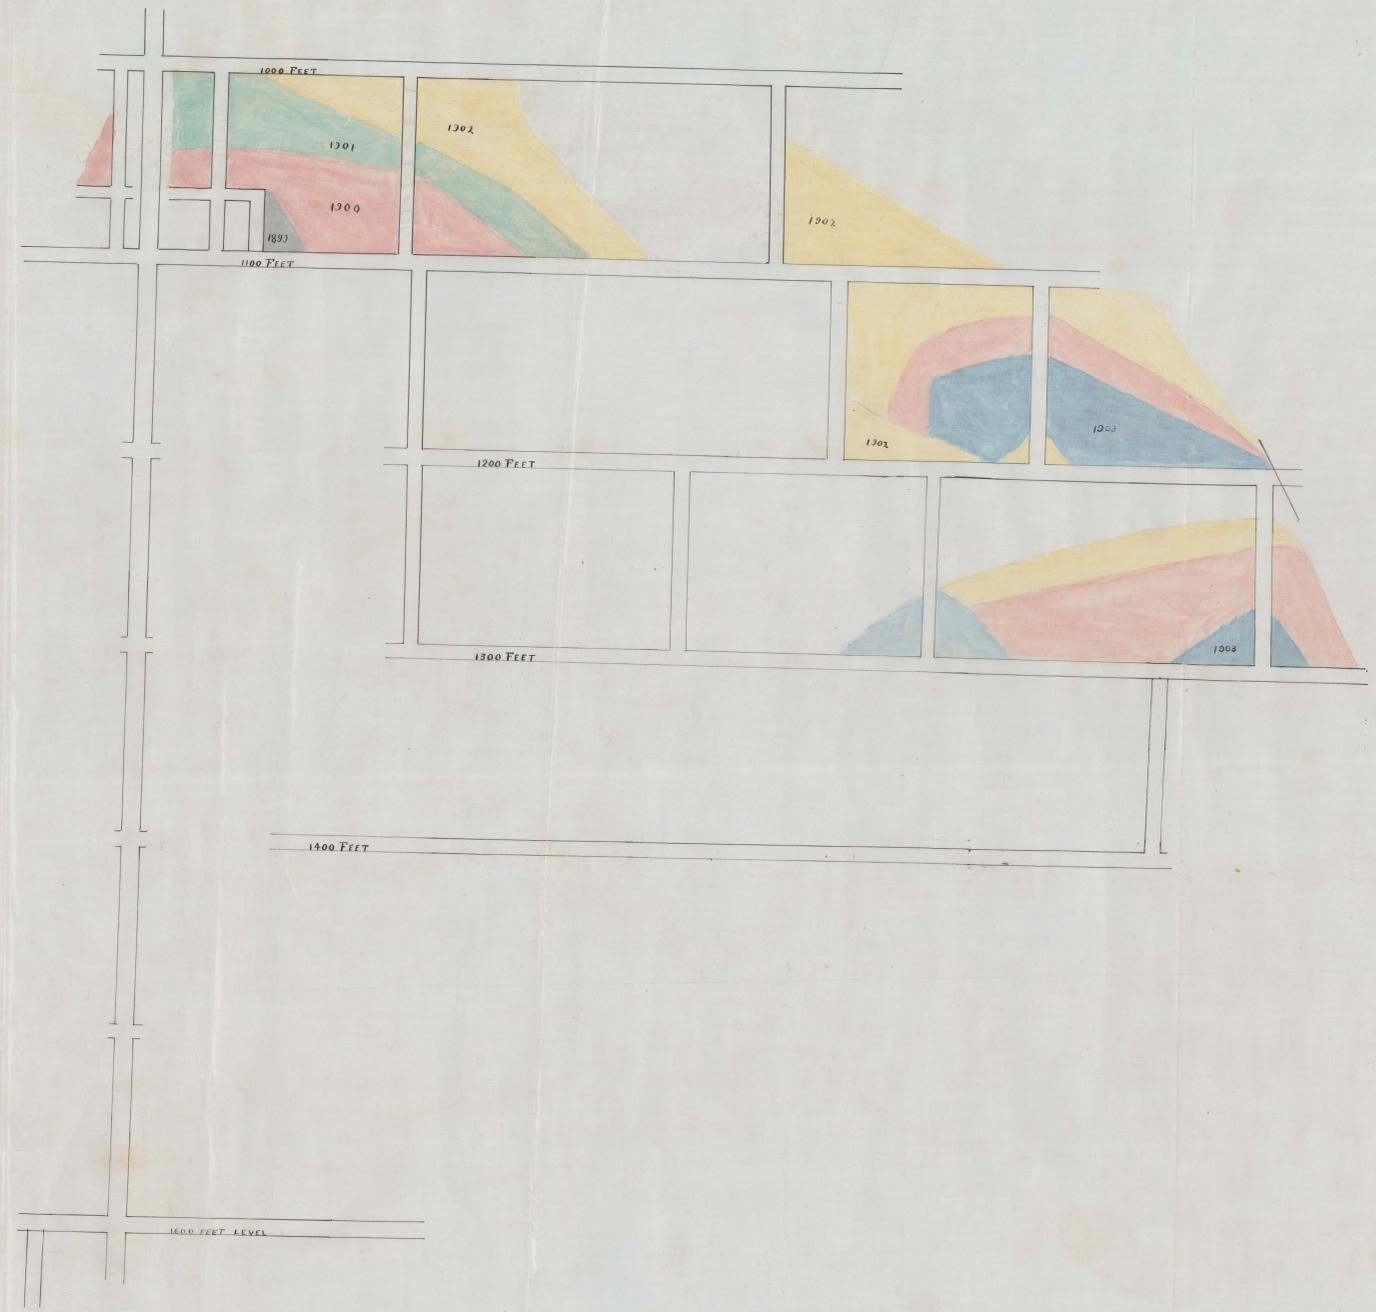


EAST REEF

SCALE 25 FEET TO ONE INCH

CROSS SECTION

SCALE 50 FEET TO ONE INCH

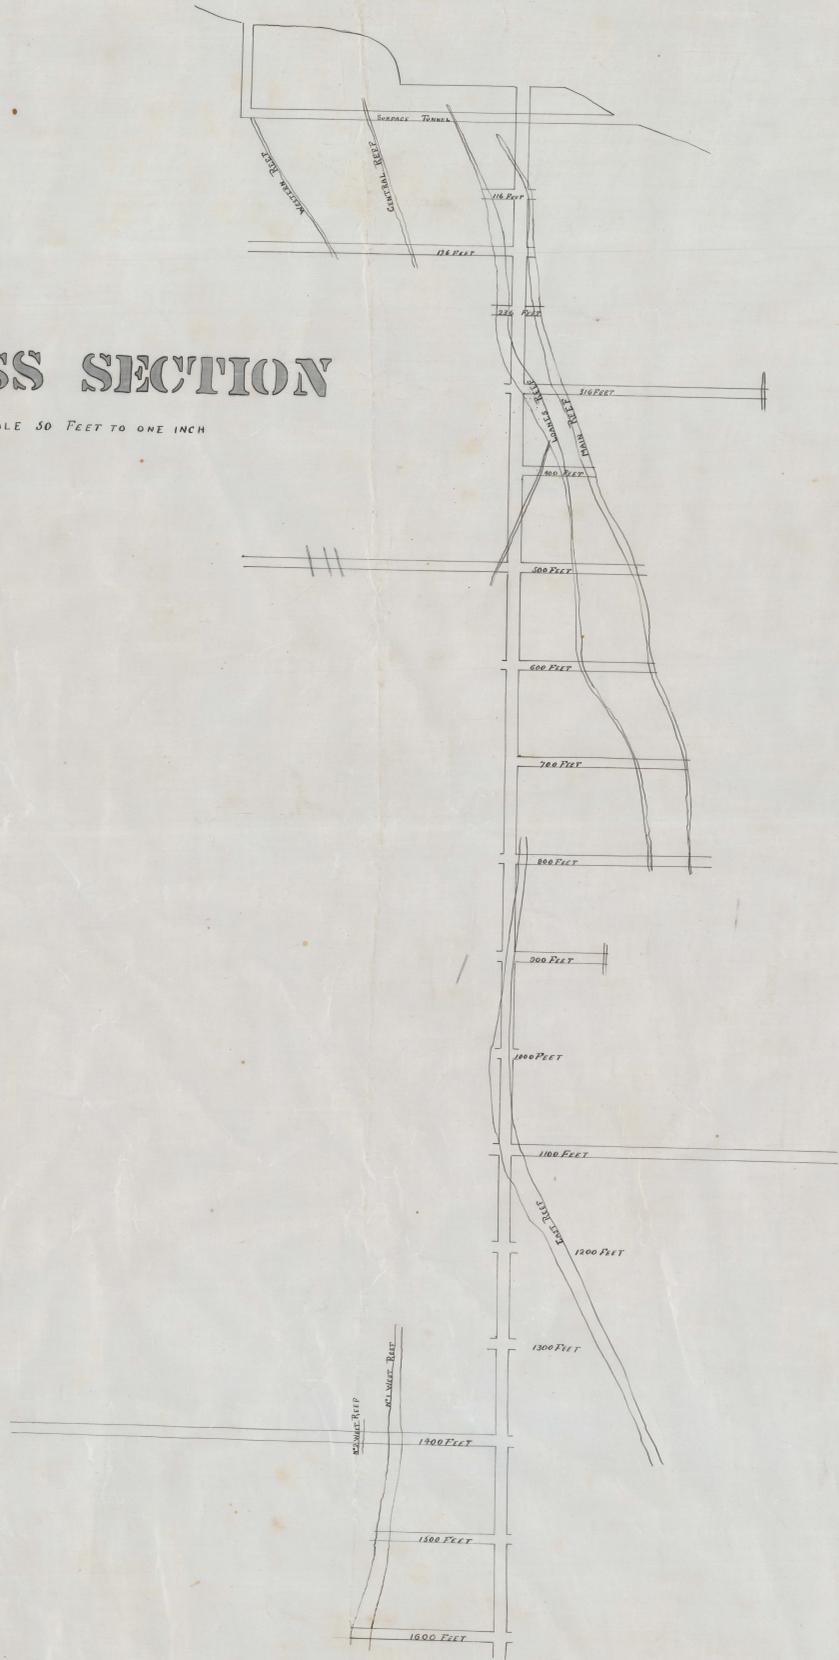

SECTION
FIRST REEF SOUTH OF SLIDE