


236-06A

5 cm

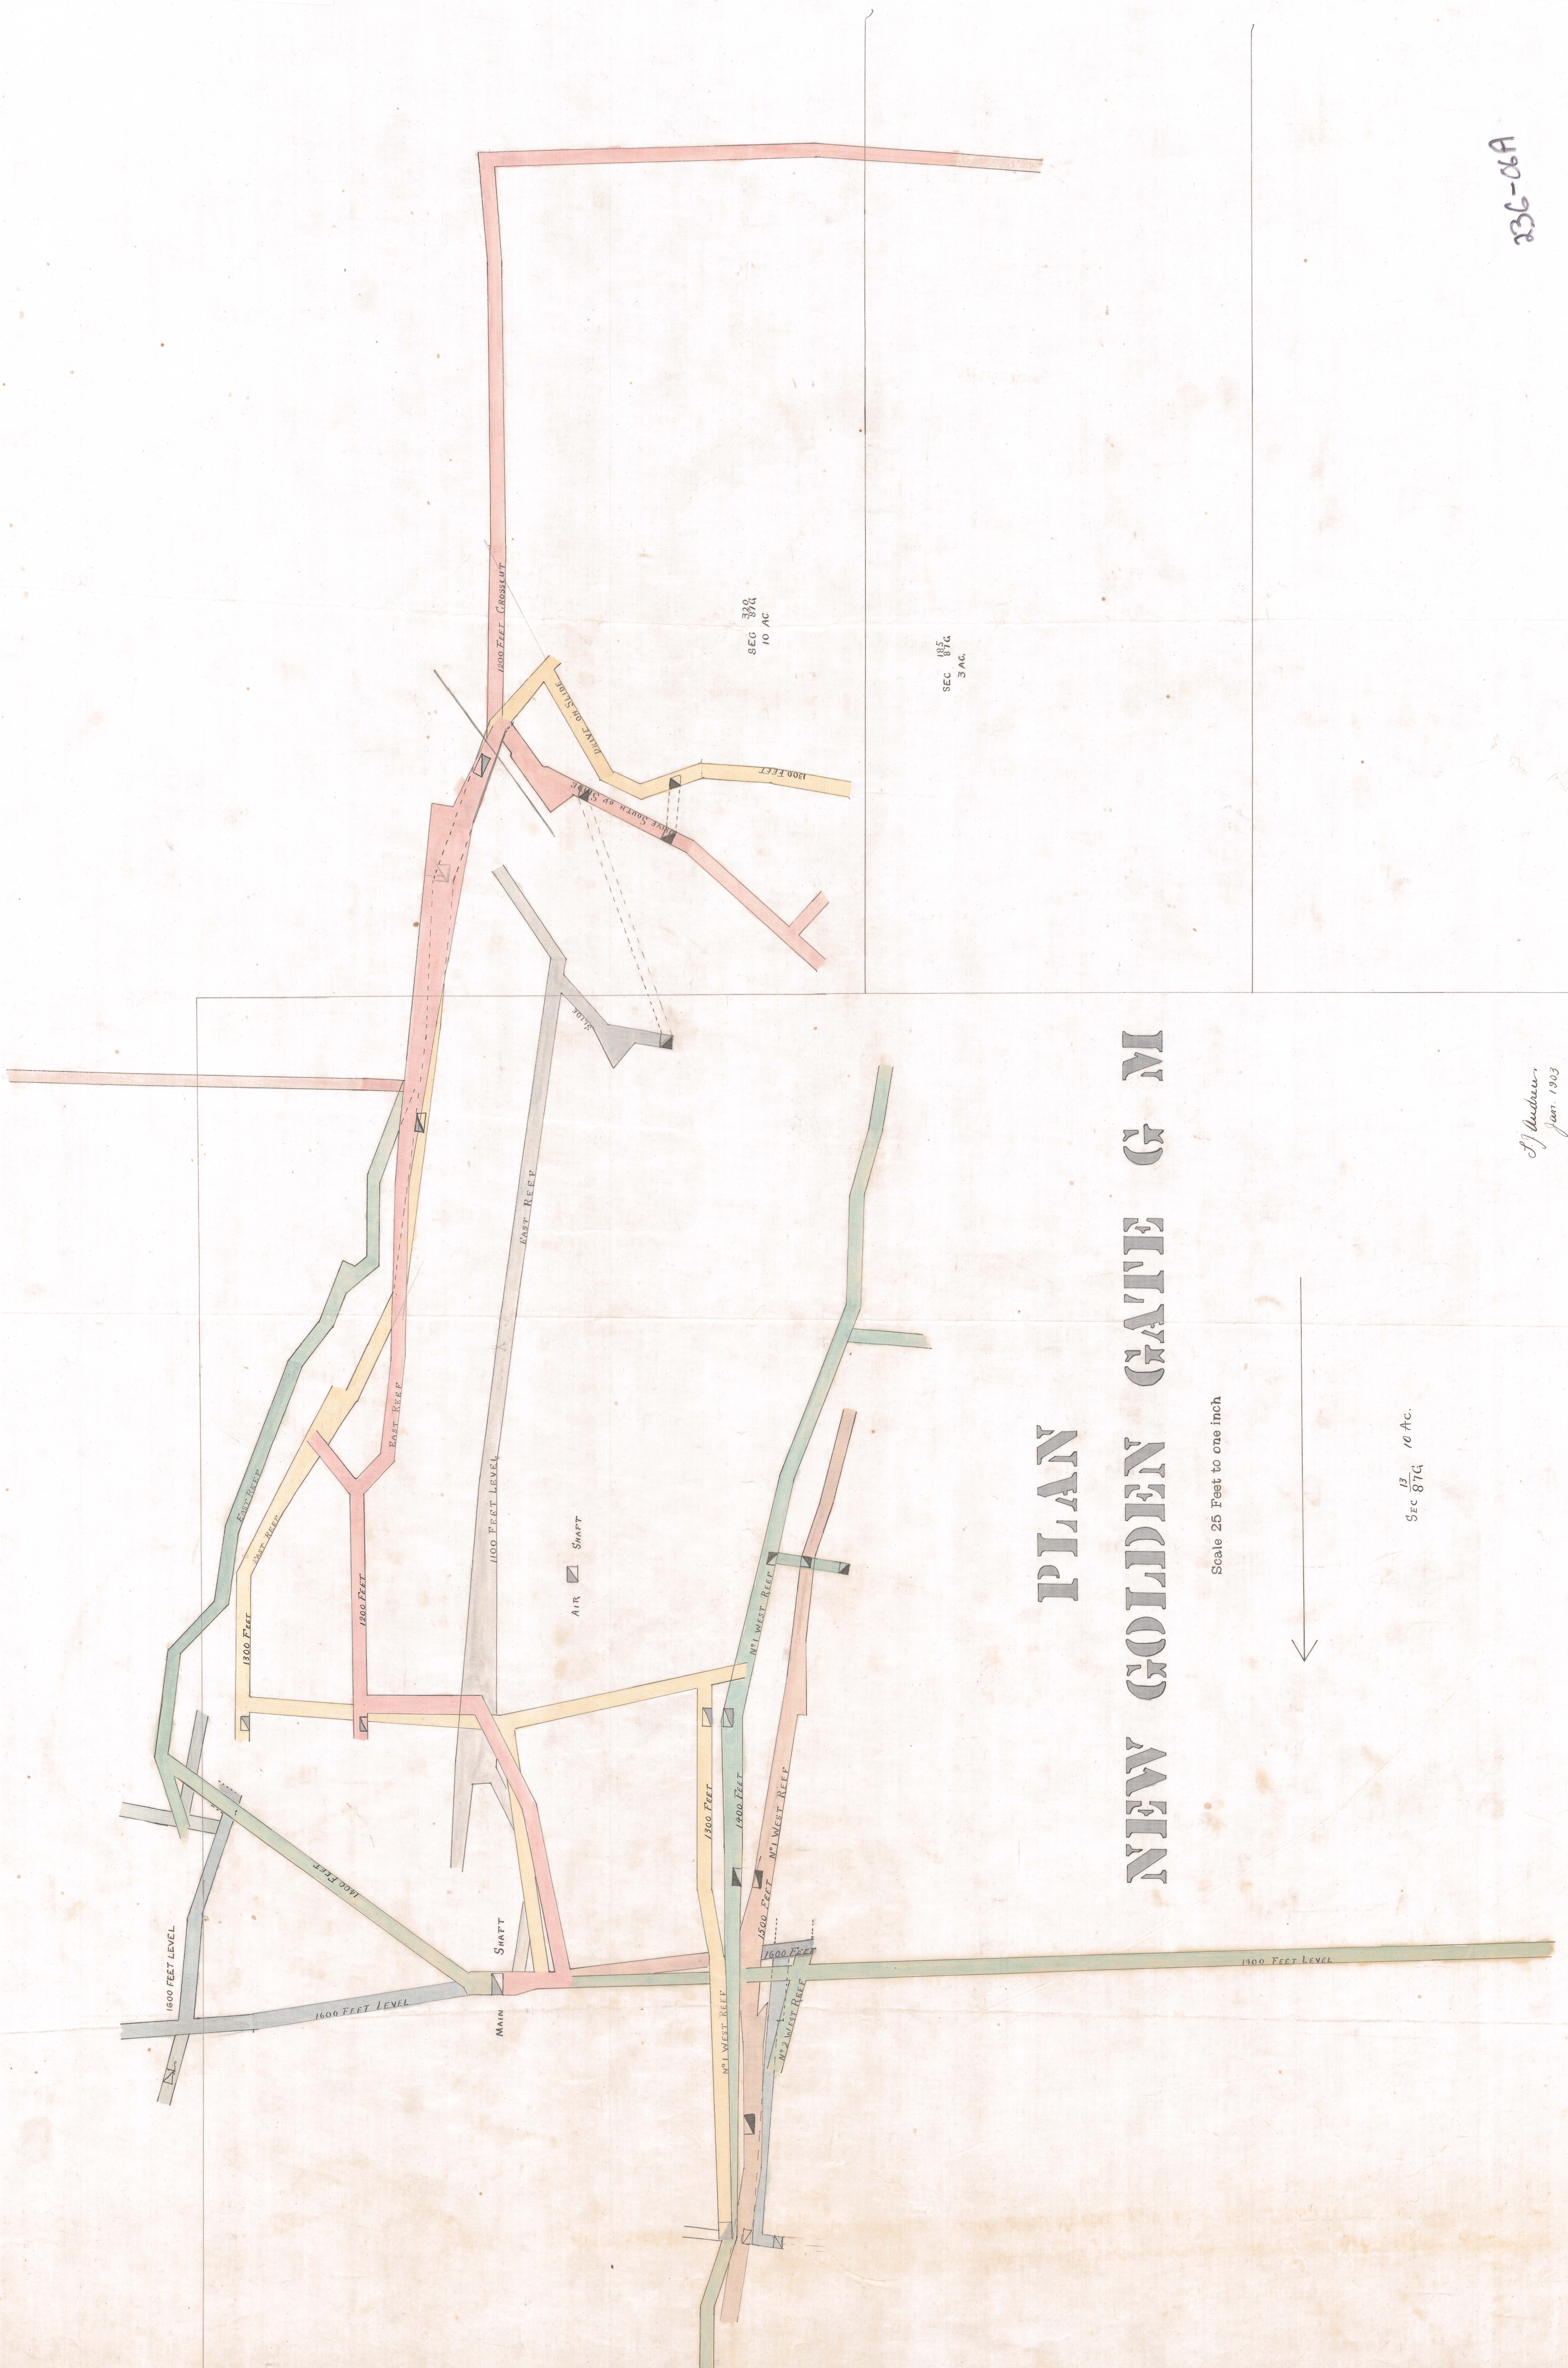

PLAN NEW GOLDEN GATE & M

Scale 25 Feet to one inch

Sec 874 10 Ac.

J. Auden
Jan. 1903