THE ALL NATIONS WOLFRAM COY REG.

MOINA. TASMANIA.

— Longitudinal Section. —

— Scale 40 ft = 1 Inch. —

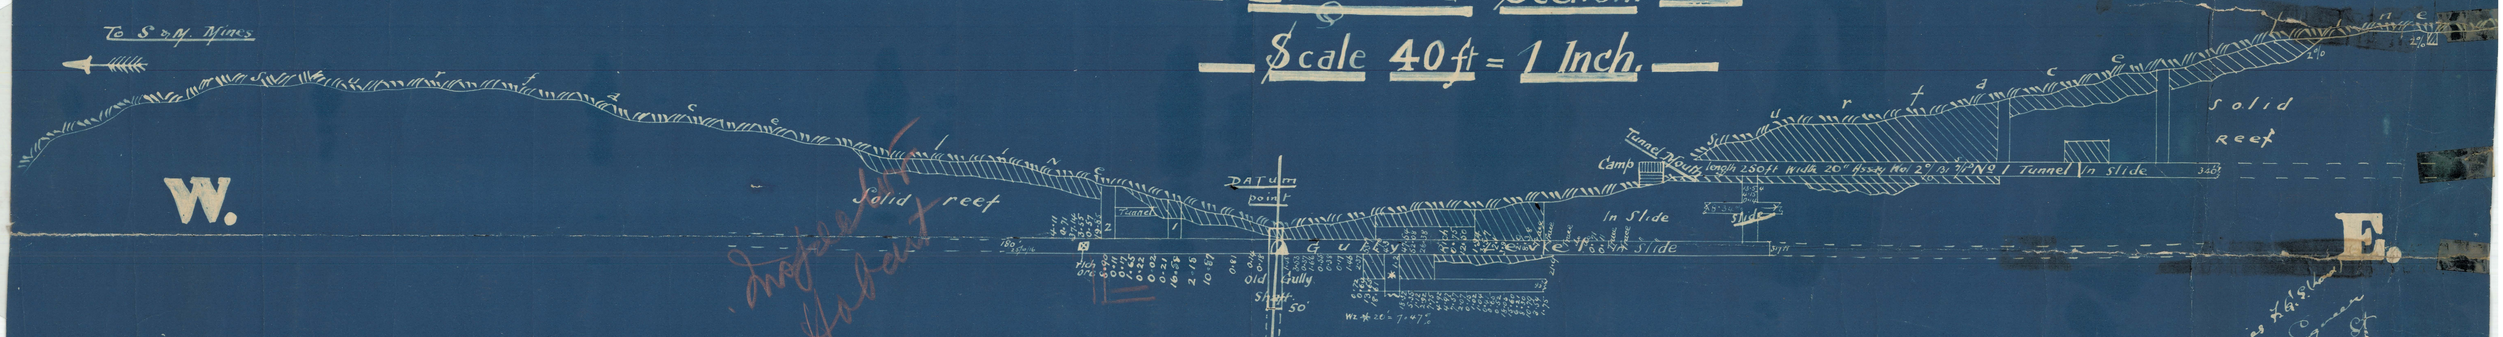

Mining Inspector Hobart

By M. L. Davies F.G.S. Consulting Engineer 148 Queen St Melb 25/10/19

287-03

287-03