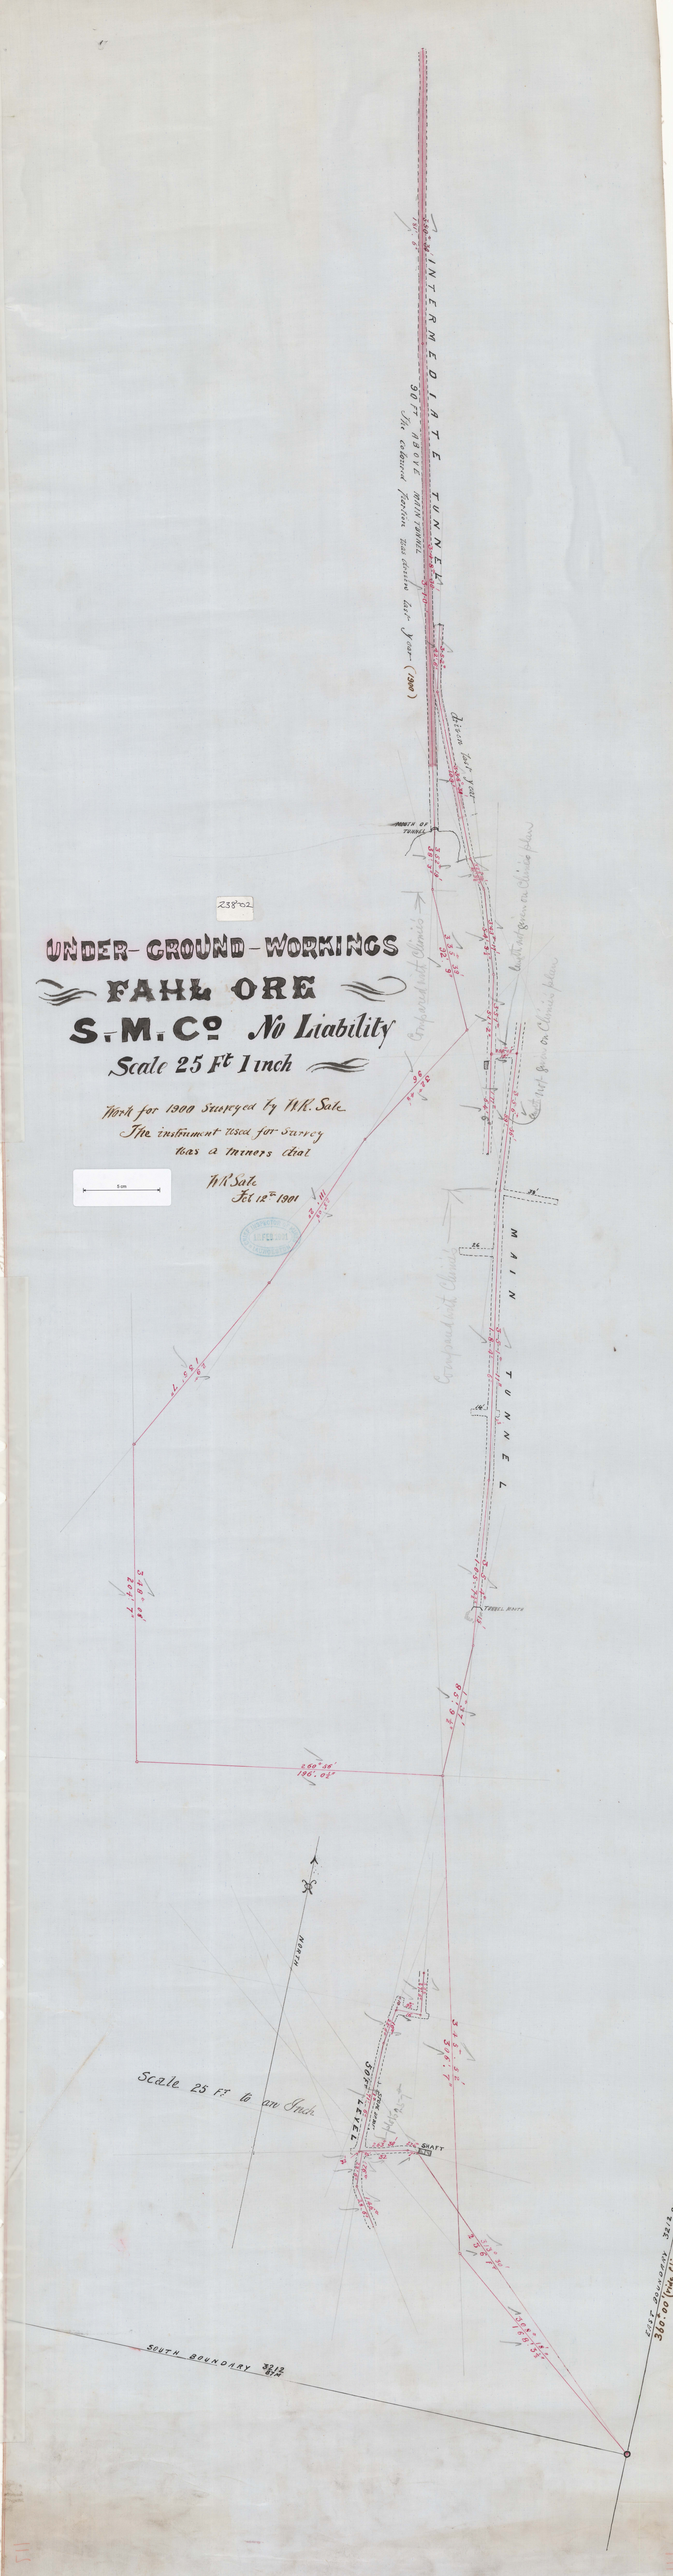
UNDER-GROUND-WORKINGS
FAHL ORE
S.M.Co No Liability
Scale 25 Ft 1 inch
Work for 1900 Surveyed by W.K. Sale
The instrument used for Survey
was a Miners dial
W.K. Sale
Feb 12th 1901
INTERMEDIATE TUNNEL
Drive last year
MOUTH OF TUNNEL
MAIN TUNNEL
STEEL BATTS
NORTH
SHAFT
Scale 25 Ft to an Inch
SOUTH BOUNDARY
