MINE WORKINGS

CURTIN-DAVIS S.M. Coy. No L.A.

239-04

Scale 30 feet to an inch

SECTION

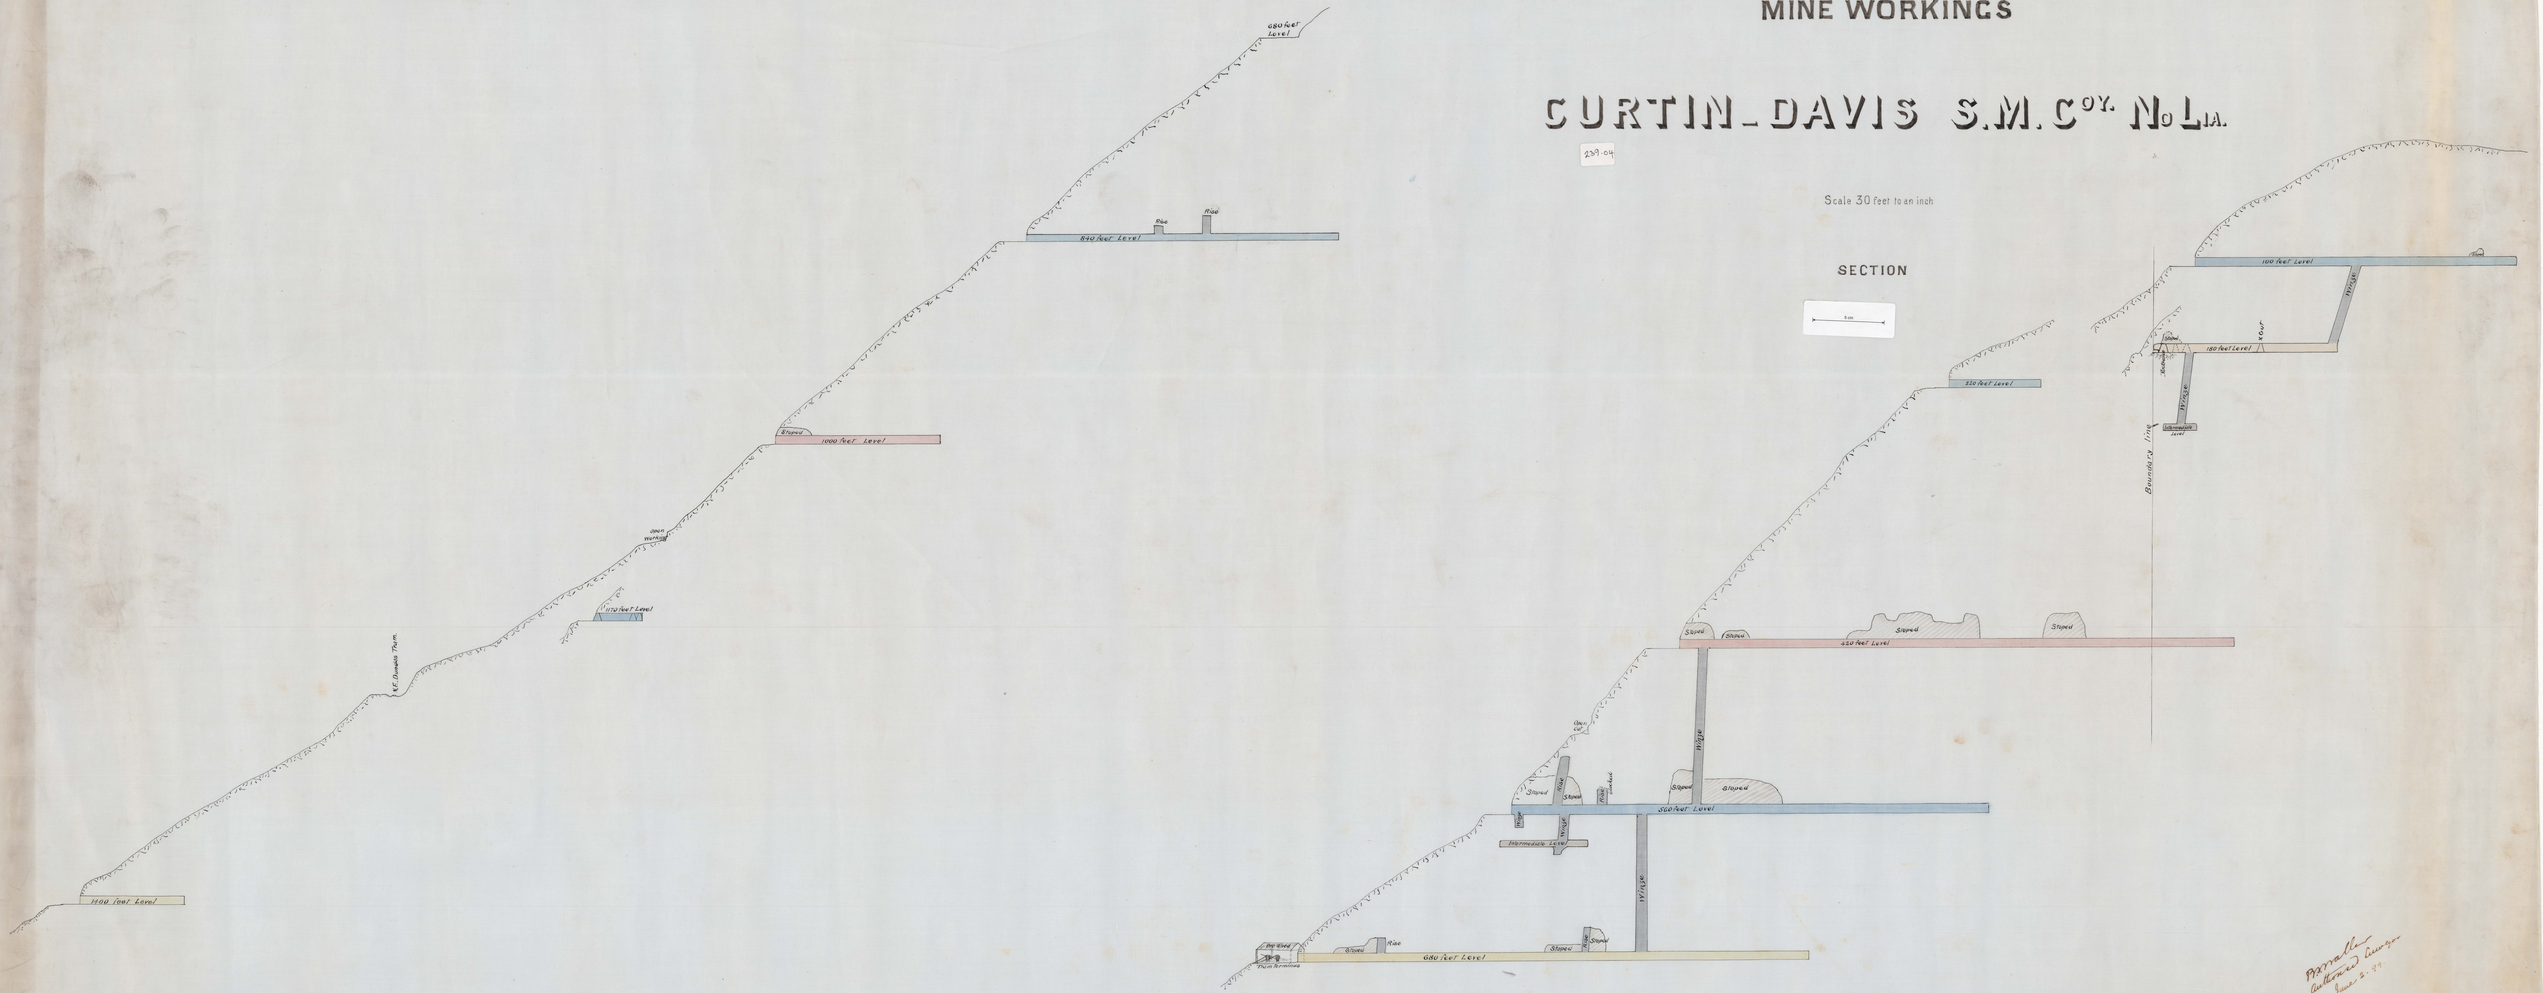

Appeal allowed Lewis 2-99