


COLEBROOK P.A. BLOCK 216 $\frac{93}{M}$

Scale-60-Feet to one Inch

149-01
149-01

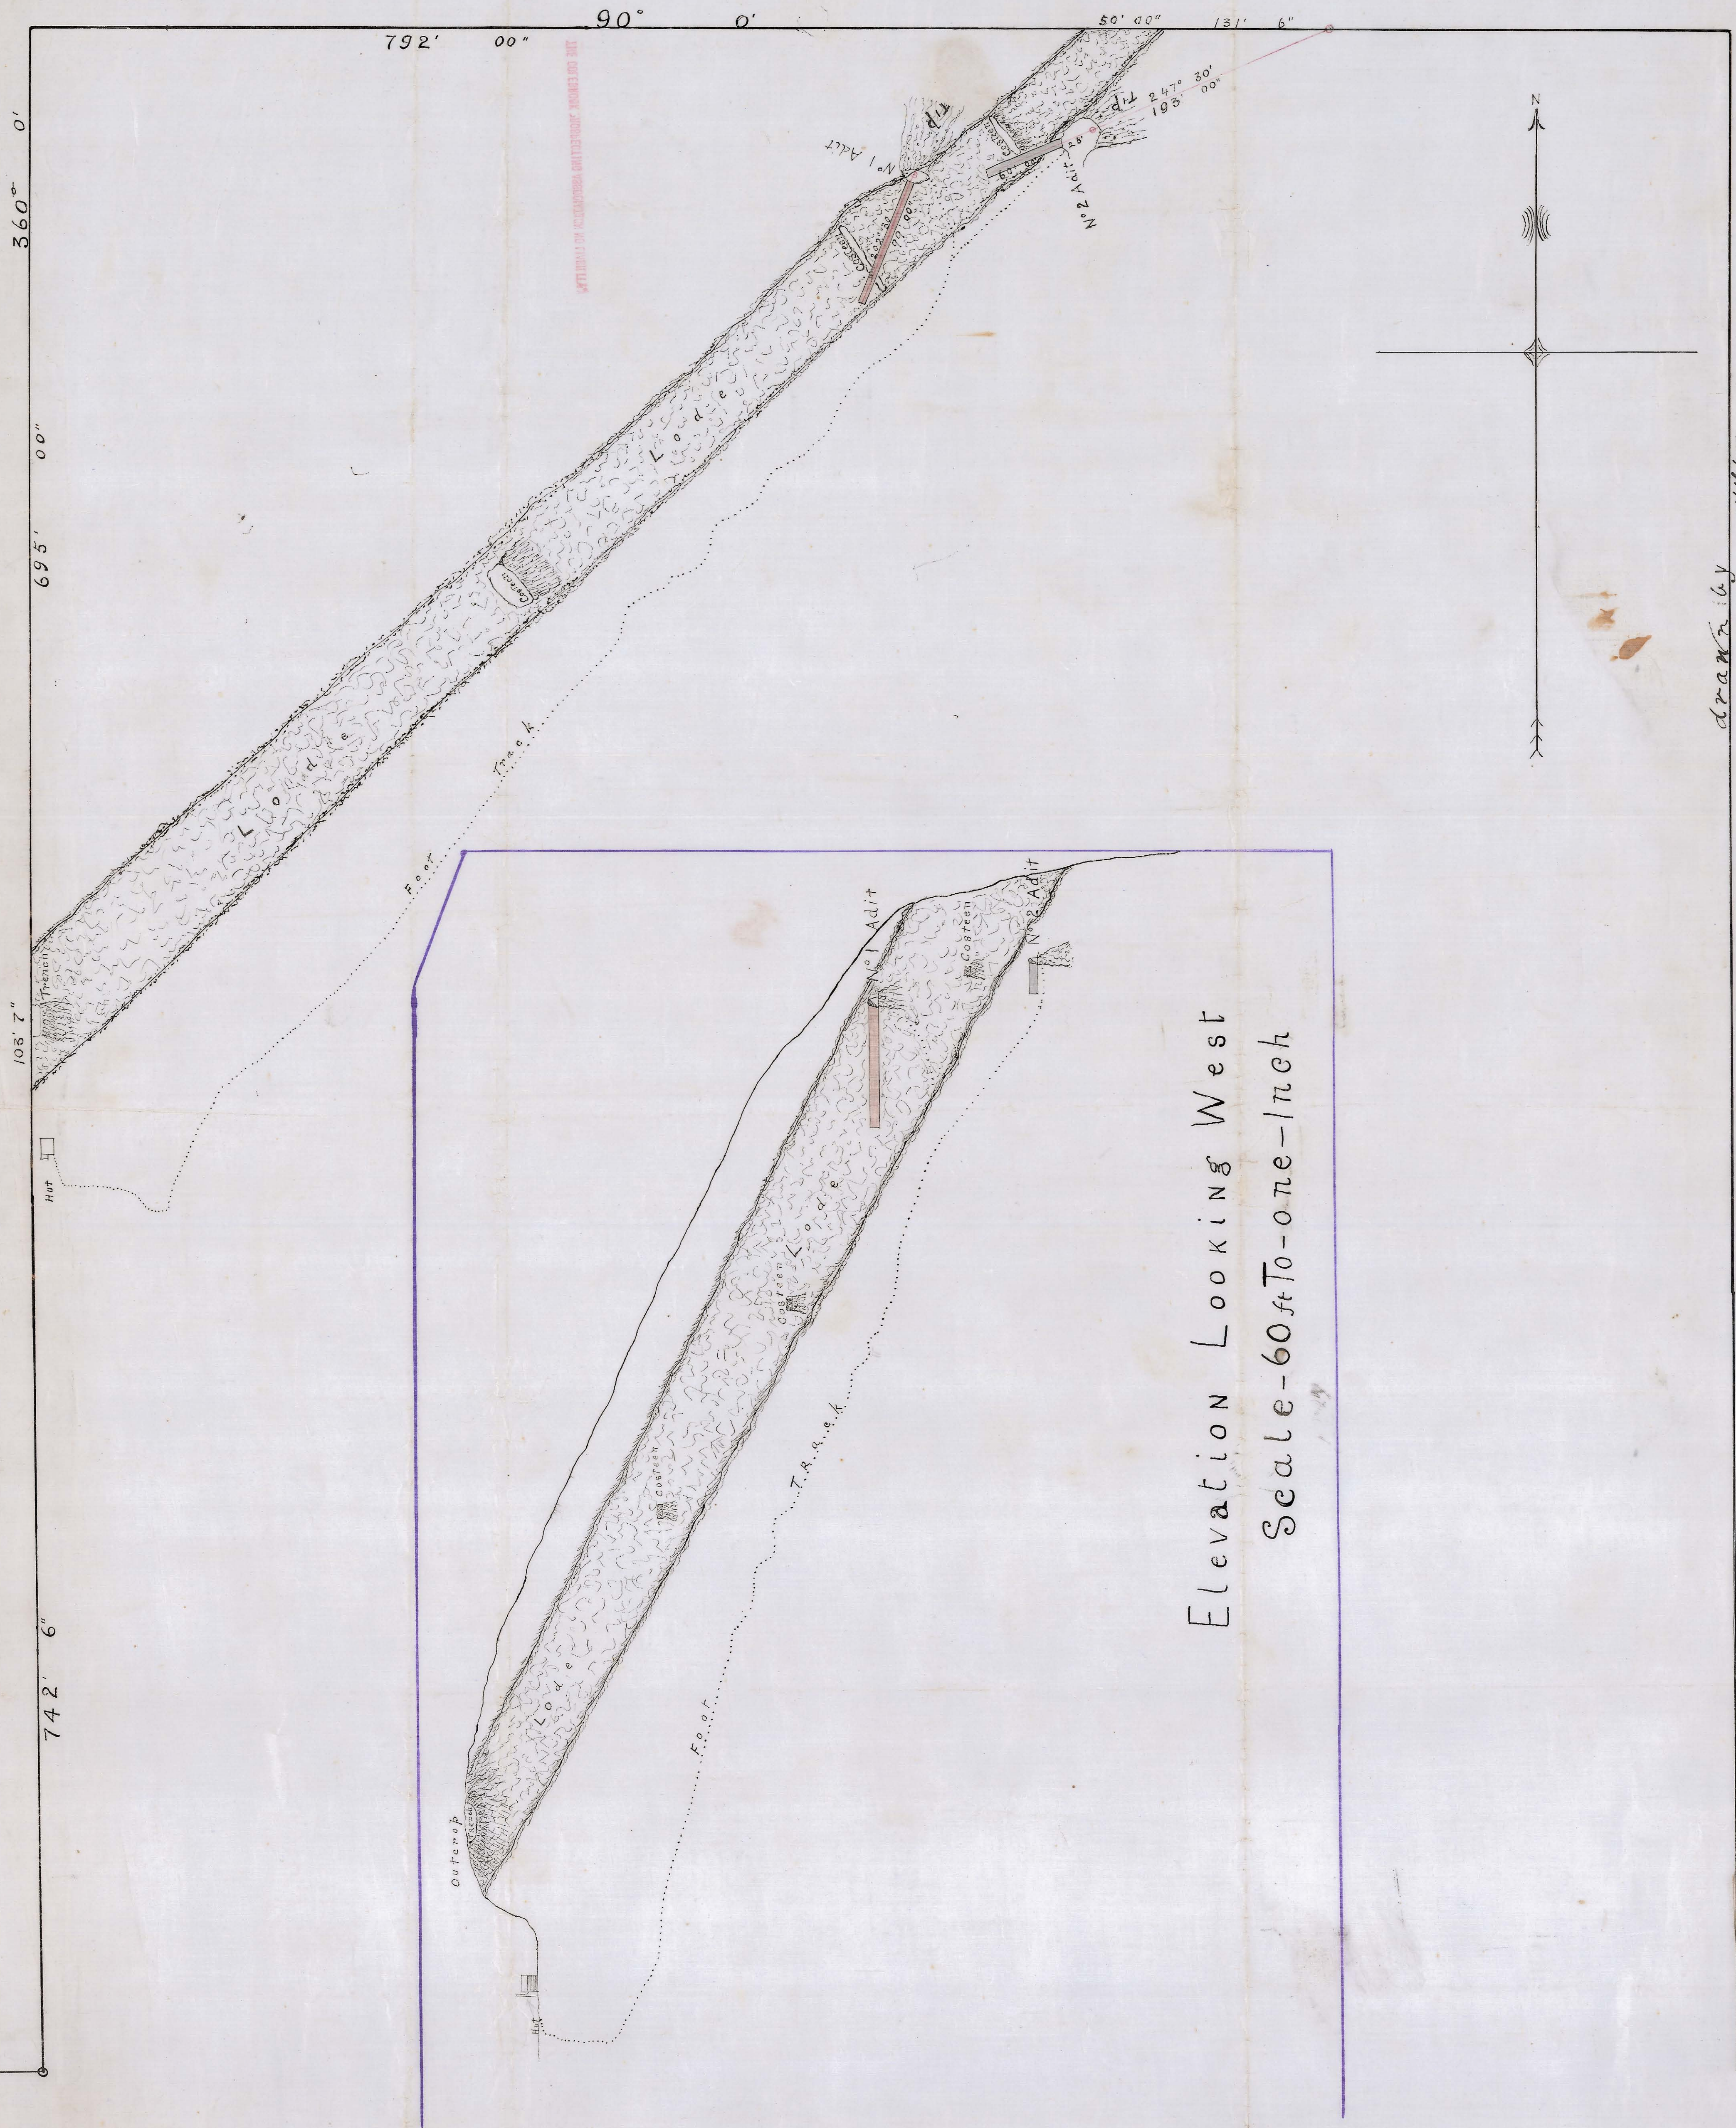

drawn by
M. H. H. H. H. H.

10-67c

2149-01

5 cm

Elevation Looking West
Scale-60ft-to-one-inch