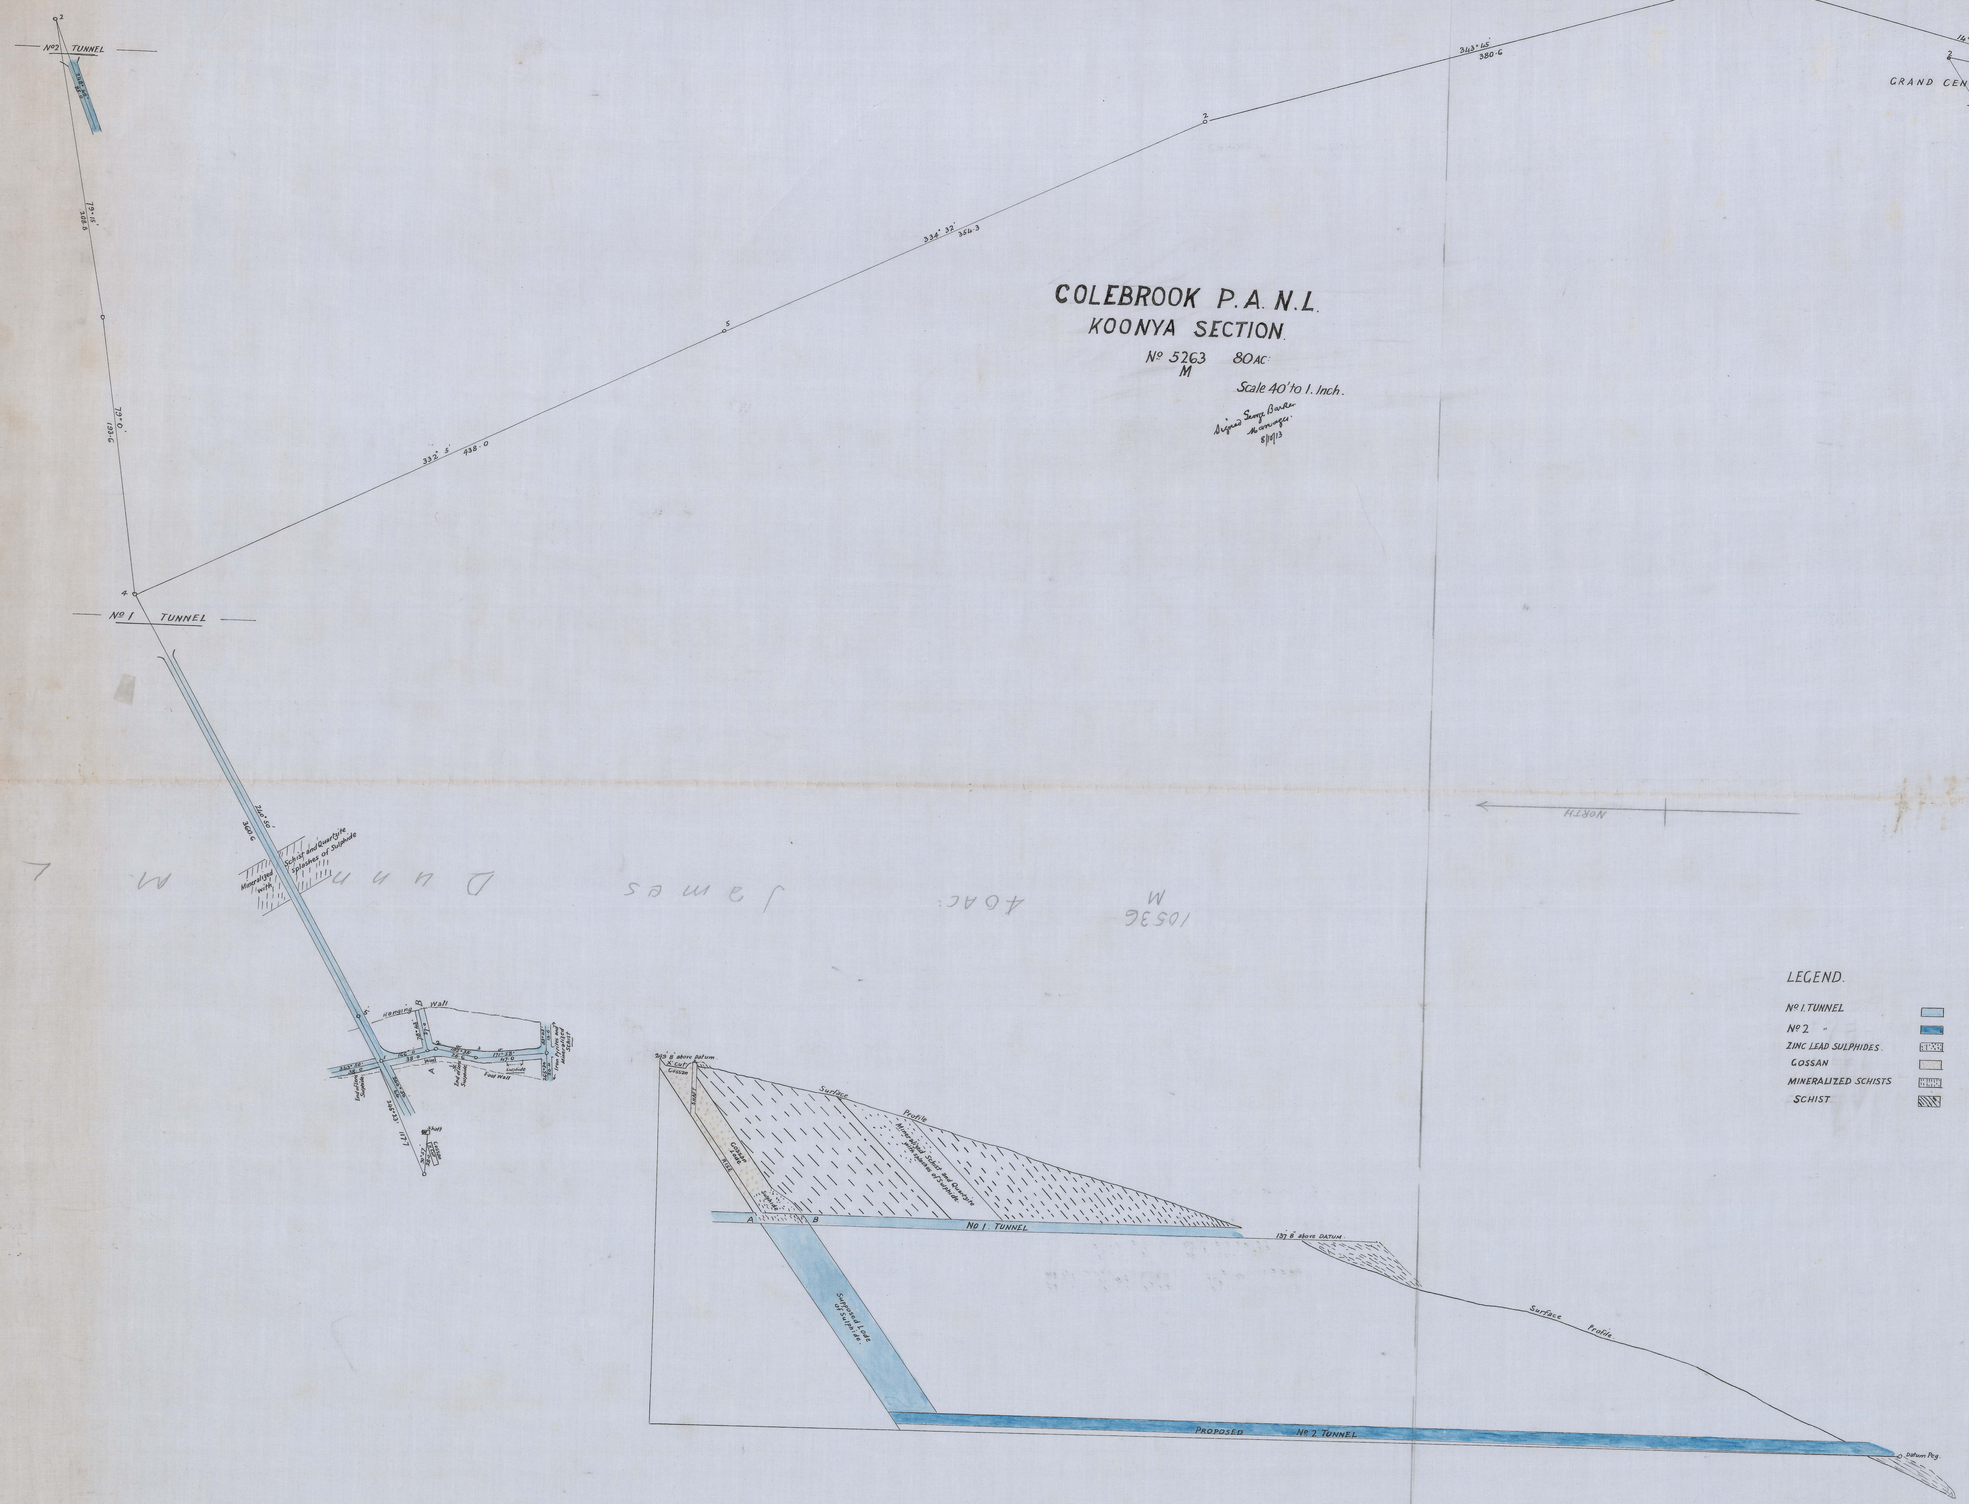

COLEBROOK P.A. 5780 M 40AC:

CENTRE SECTION. 5264 M 64AC:

GRAND

249-04

249-03 TOL-REE

249-04

5cm