


COLEBROOK MINE

ORRVILLE

Scale 25 Feet is an Inch

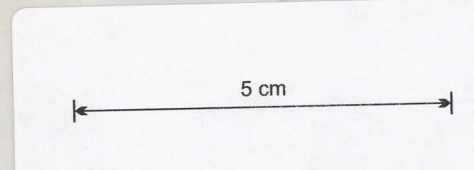

321 93 M


80 Ac.

239 93M

60 Ac.

216 93 M

68 Ac.

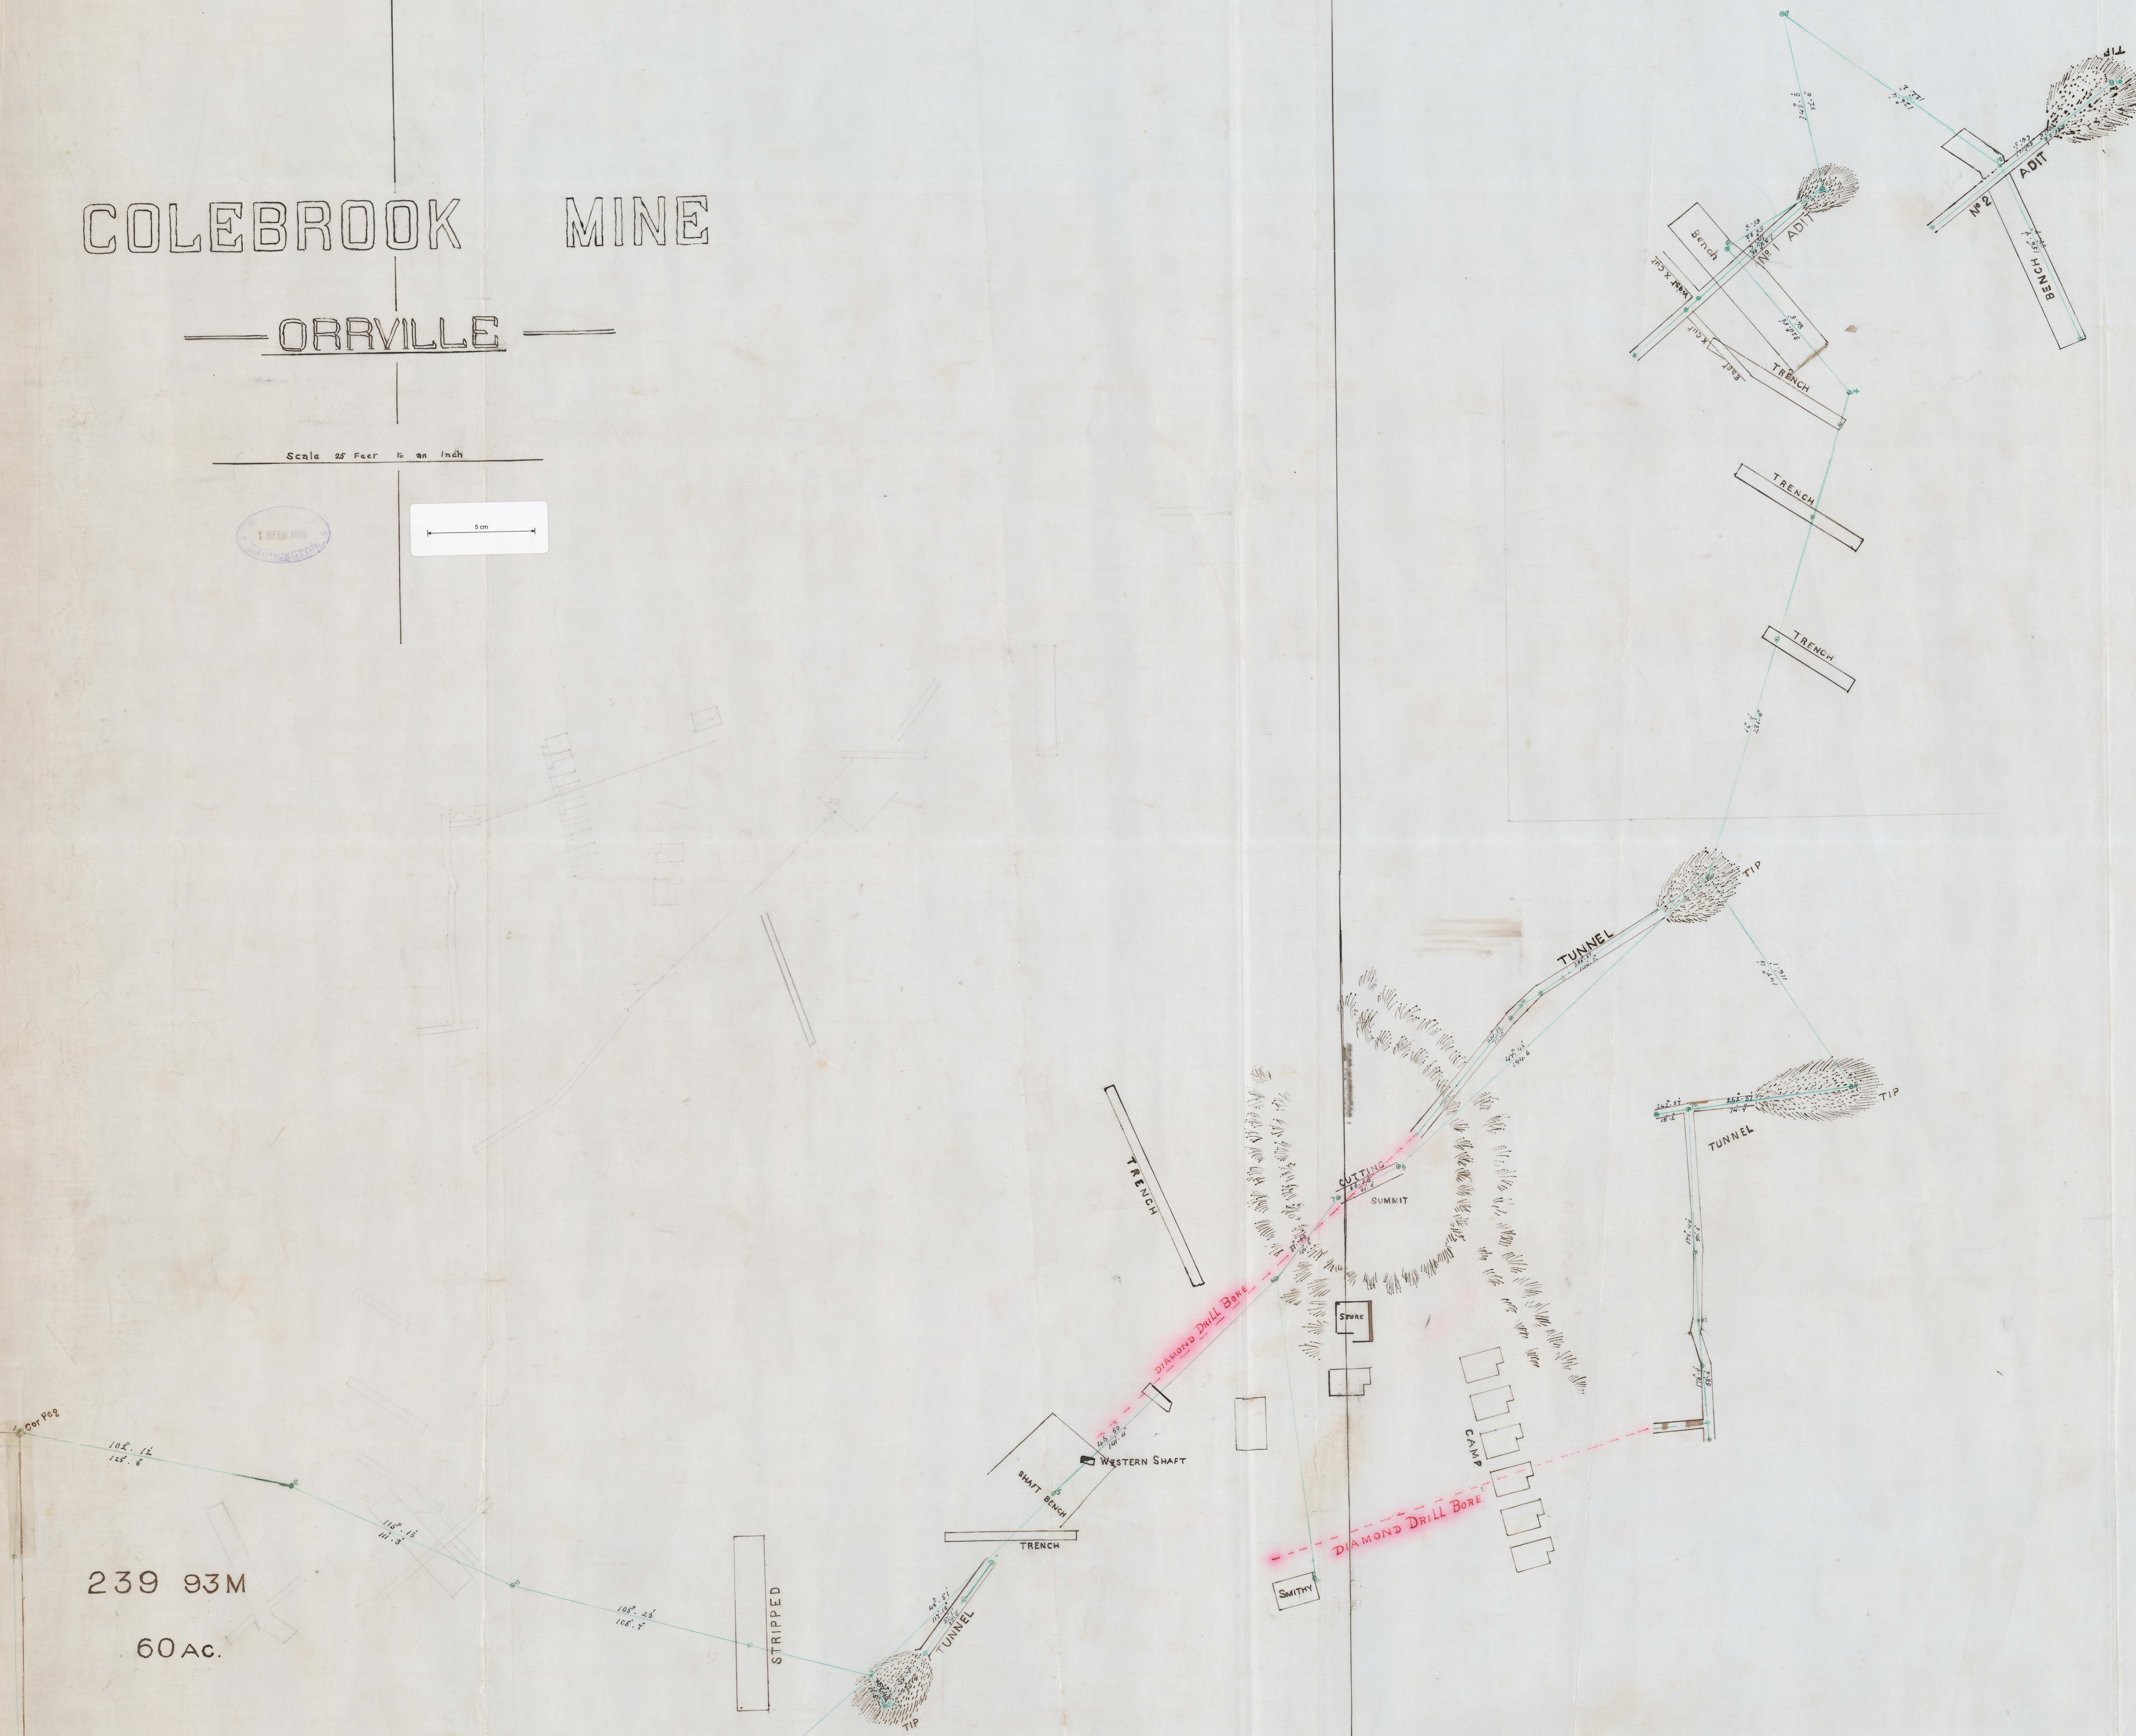

216-07