YORK PLAINS COLLIERY

C. J. C. LORD OWNER

Scale 30 feet to an inch.

WORKINGS FOR 1898 to DATE

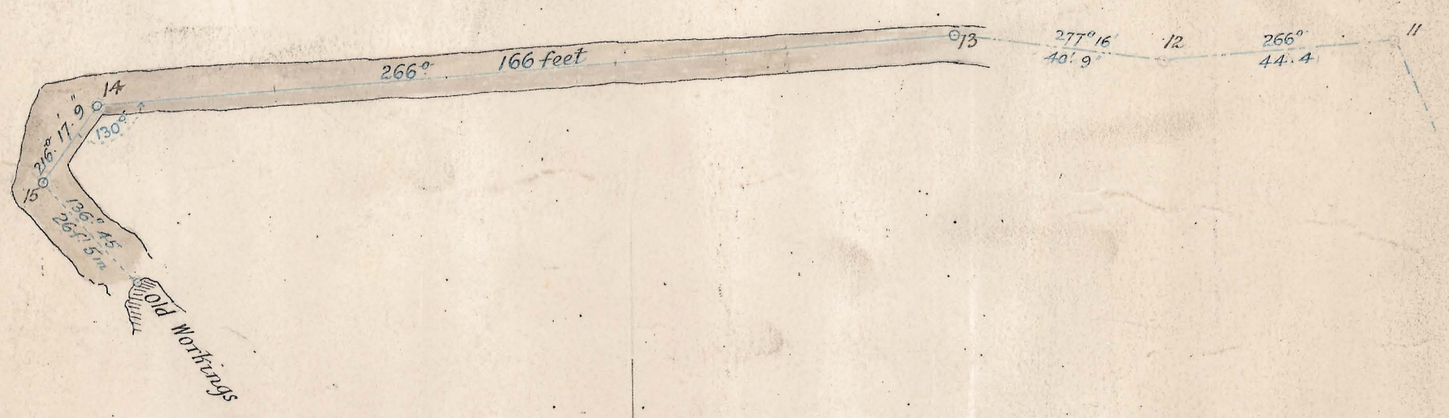

Instrument used 5 in: Theodolite
Steel band chain
Date of Survey 28th April 1899

George T. Lovell
Authorised Surveyor
April 1899

260-10
260-10