


MANCANA COLD REEFS COY L¹⁰

NEW SOVEREIGN MINE

Scale 25 ft to 1 inch

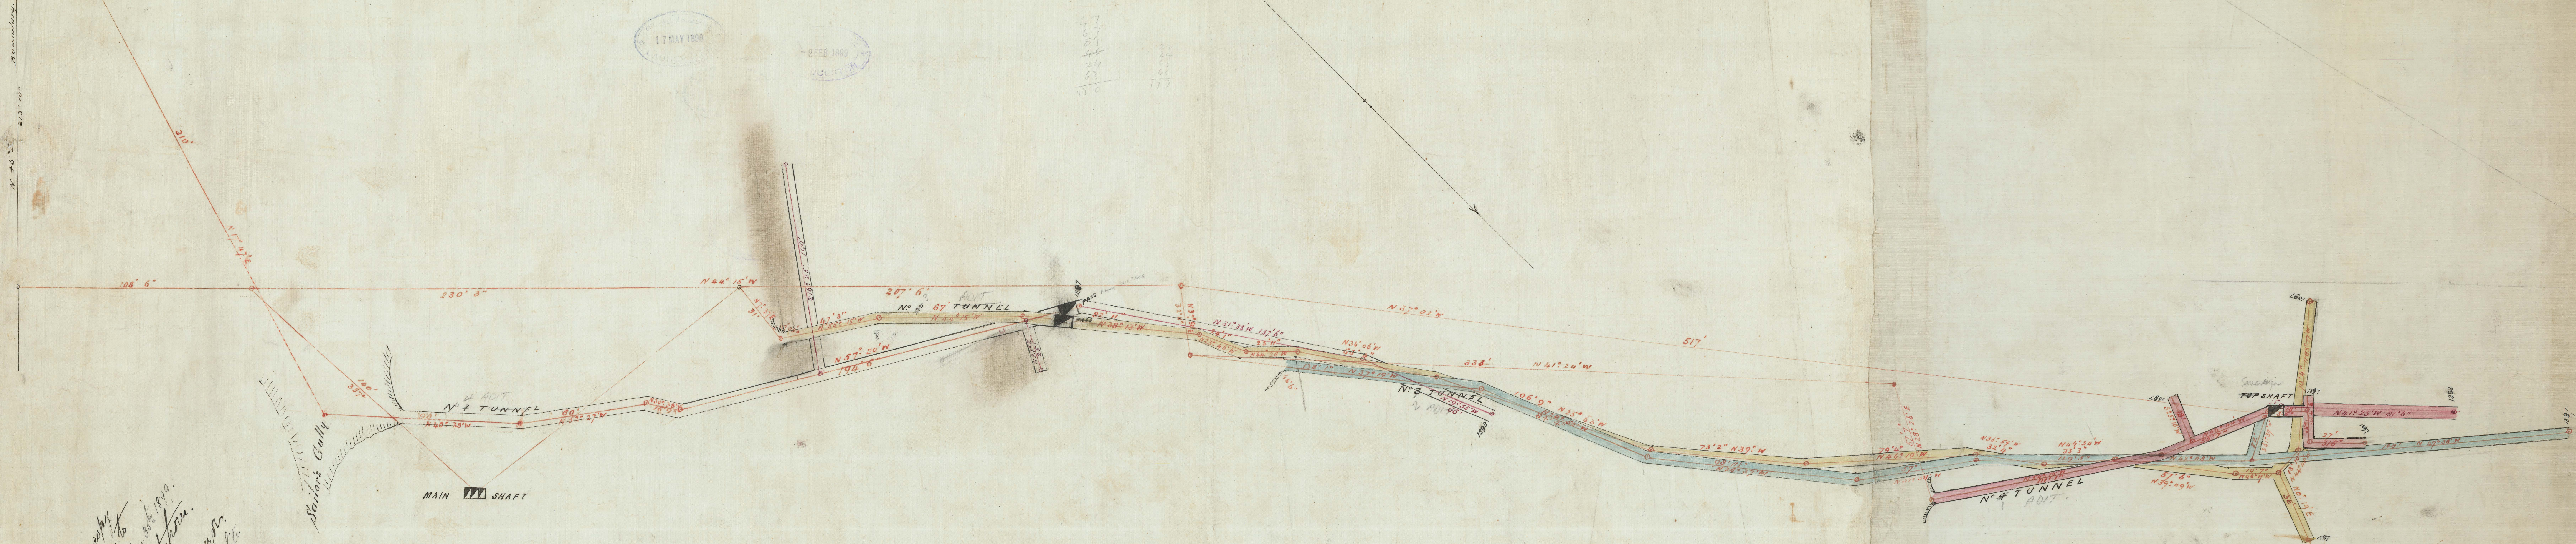

*Circular sent copy
of plan of workshop to
May 29. 6.
to George Watson.
Watson.
Larimer with Goodwin.*