266-03

669.

266-03

5 cm

956.

753

642.

660.

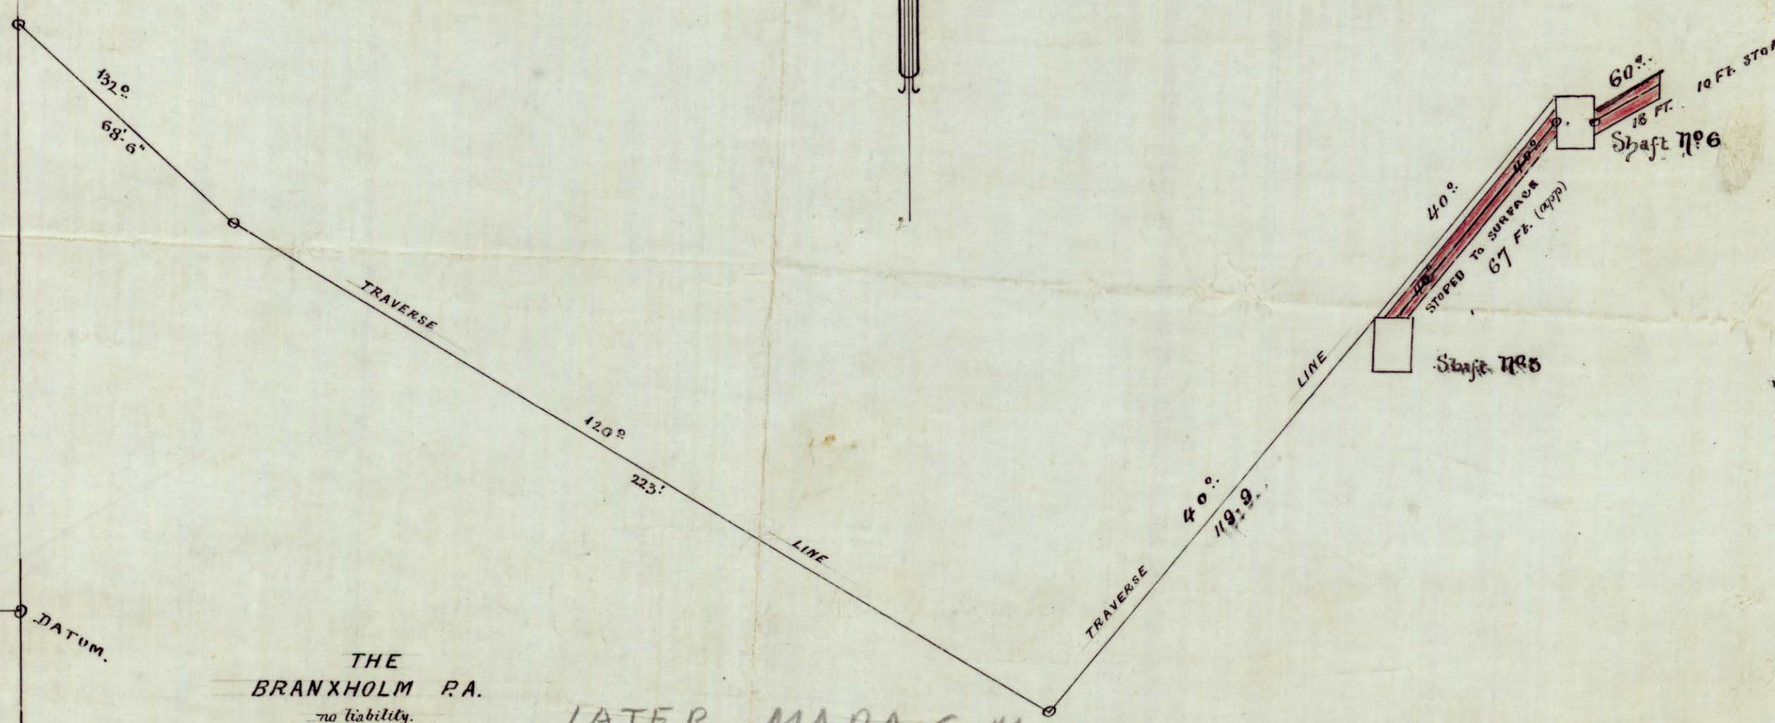

THE
BRANXHOLM P.A.
no liability.

PLAN
of the underground workings

taken by "Prismatic Compass" 14th May 1895.

Evelyn
Surveyor

LATER MARAG Mine
WARRENTINNA

INSPECTOR OF MINES OFFICE
29th May
1895
LAUNCESTON

REFERENCE.

No 6 Shaft depth 34 ft.
. 3 . . 64 ft.

opened out at bottom no 6 shaft & followed the reef down to bottom of No 6 shaft.

Scale 30 feet to the inch.

664P/32