EAST VOLUNTEER. G. M. Co. N L

Scale 25 feet to an inch

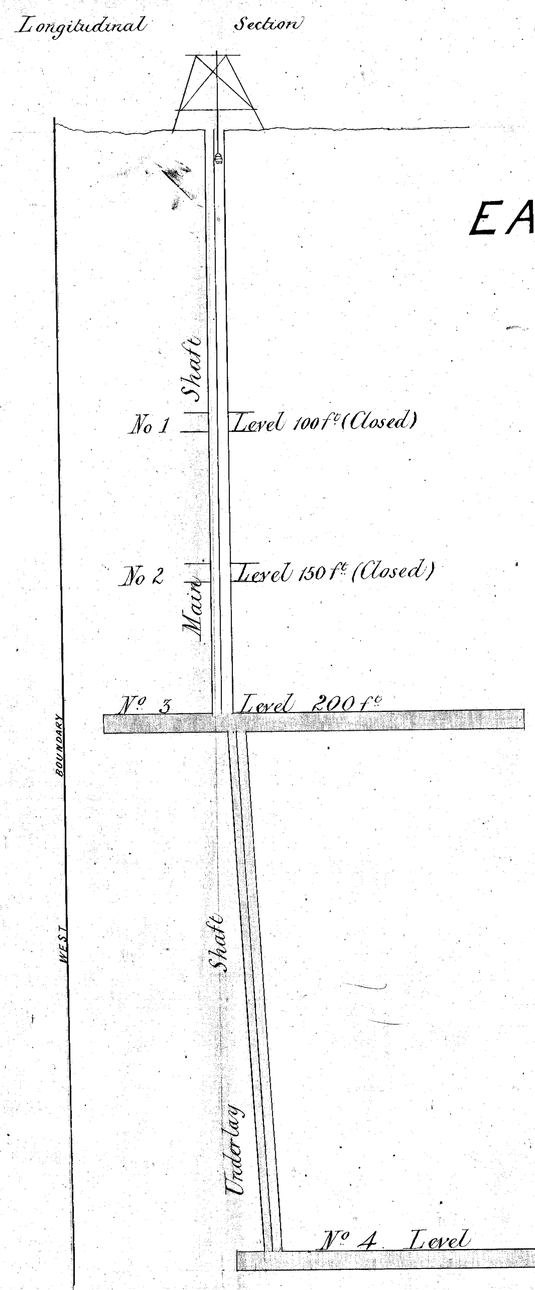

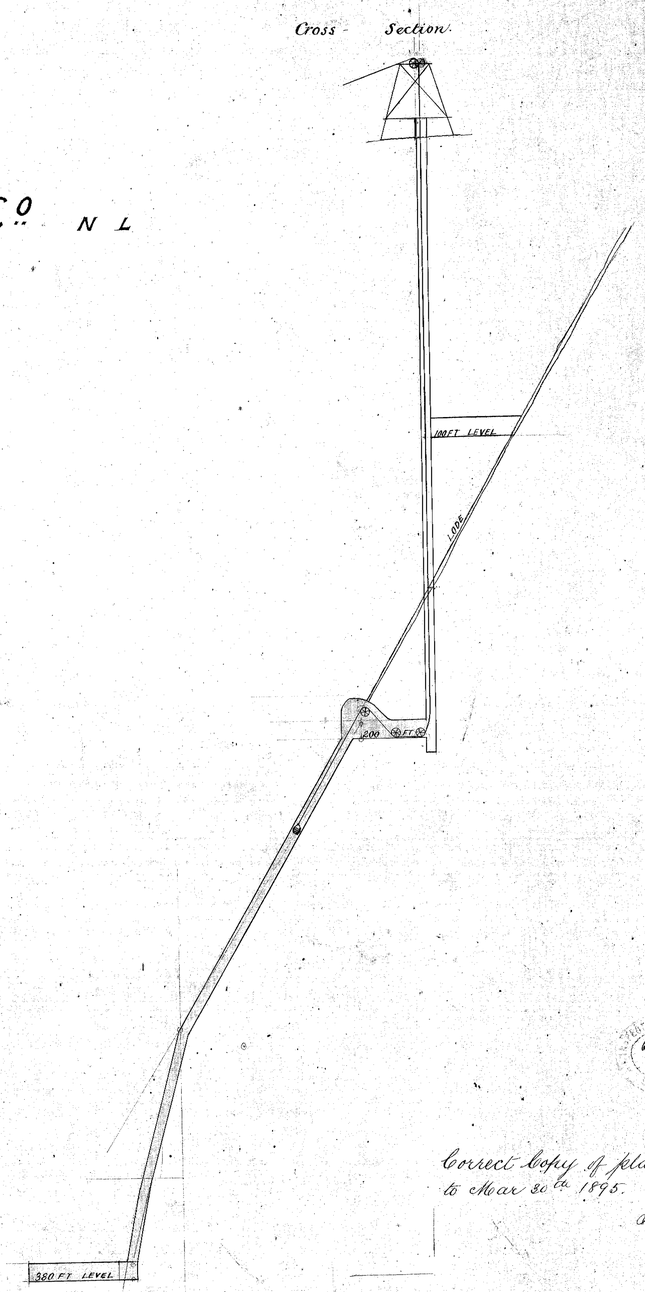

Correct copy of plan from actual Survey to Mar 30th 1895.

N. S. Mills
Authorised Surveyor
Leprey
2/4/95.

6th April 1895.
LONGESTON

5 cm