


No. 1. Section

New Cosmopolitan G.M.C.

Tracing of Plans
Mining Engineer

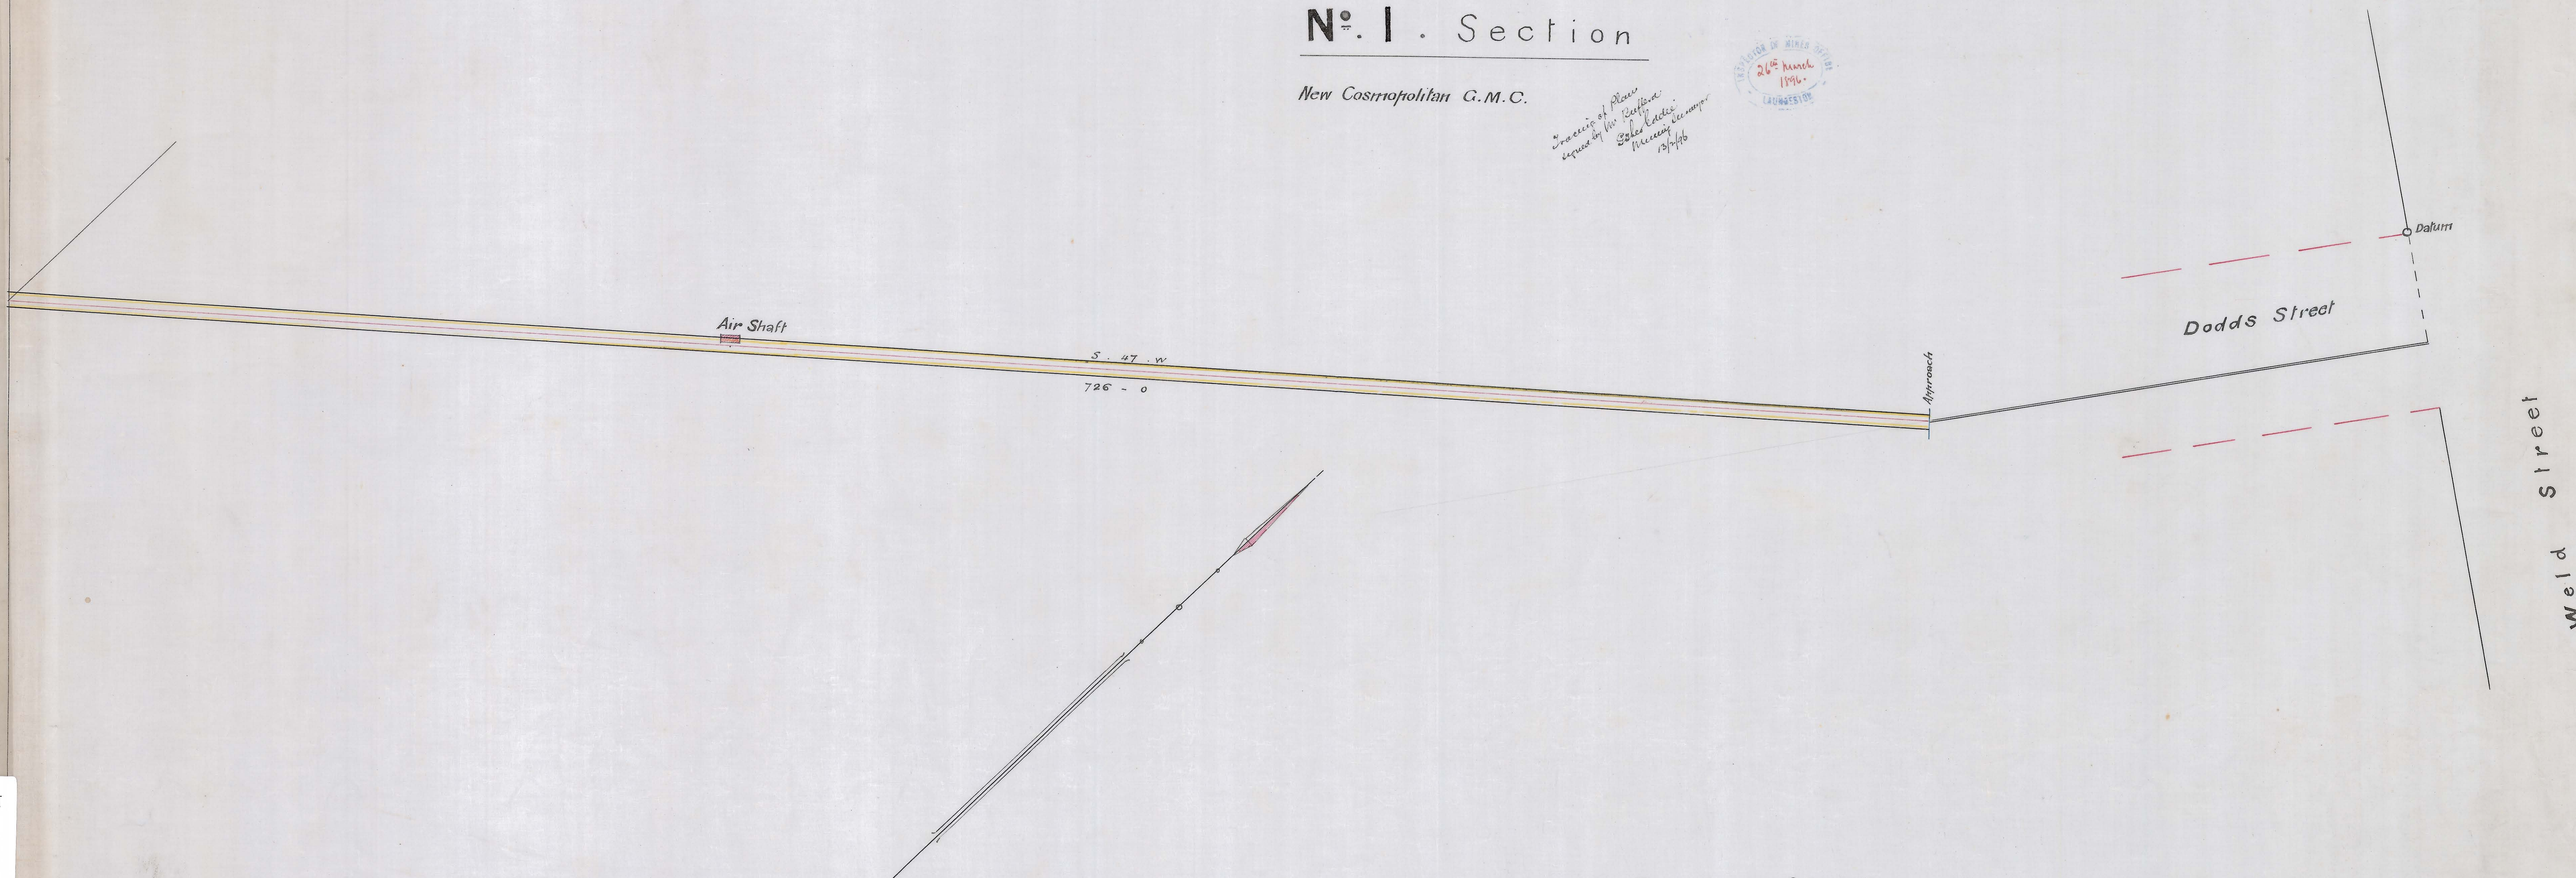

Scale 25 Feet to an inch

(Signed) S. B. Burford
Mining Engineer

5 cm

270-07

1881-1882