THE NEW COSMOPOLITAN G M C

NO LIABILITY

BEACONSFIELD

Tracing of Plan
Signed by Mr Pearce
Stokes Reeves
Mining Surveyor
13/4/96

TASMANIAN DEPARTMENT OF MINES
24th March 1896.
LAUNCESTON

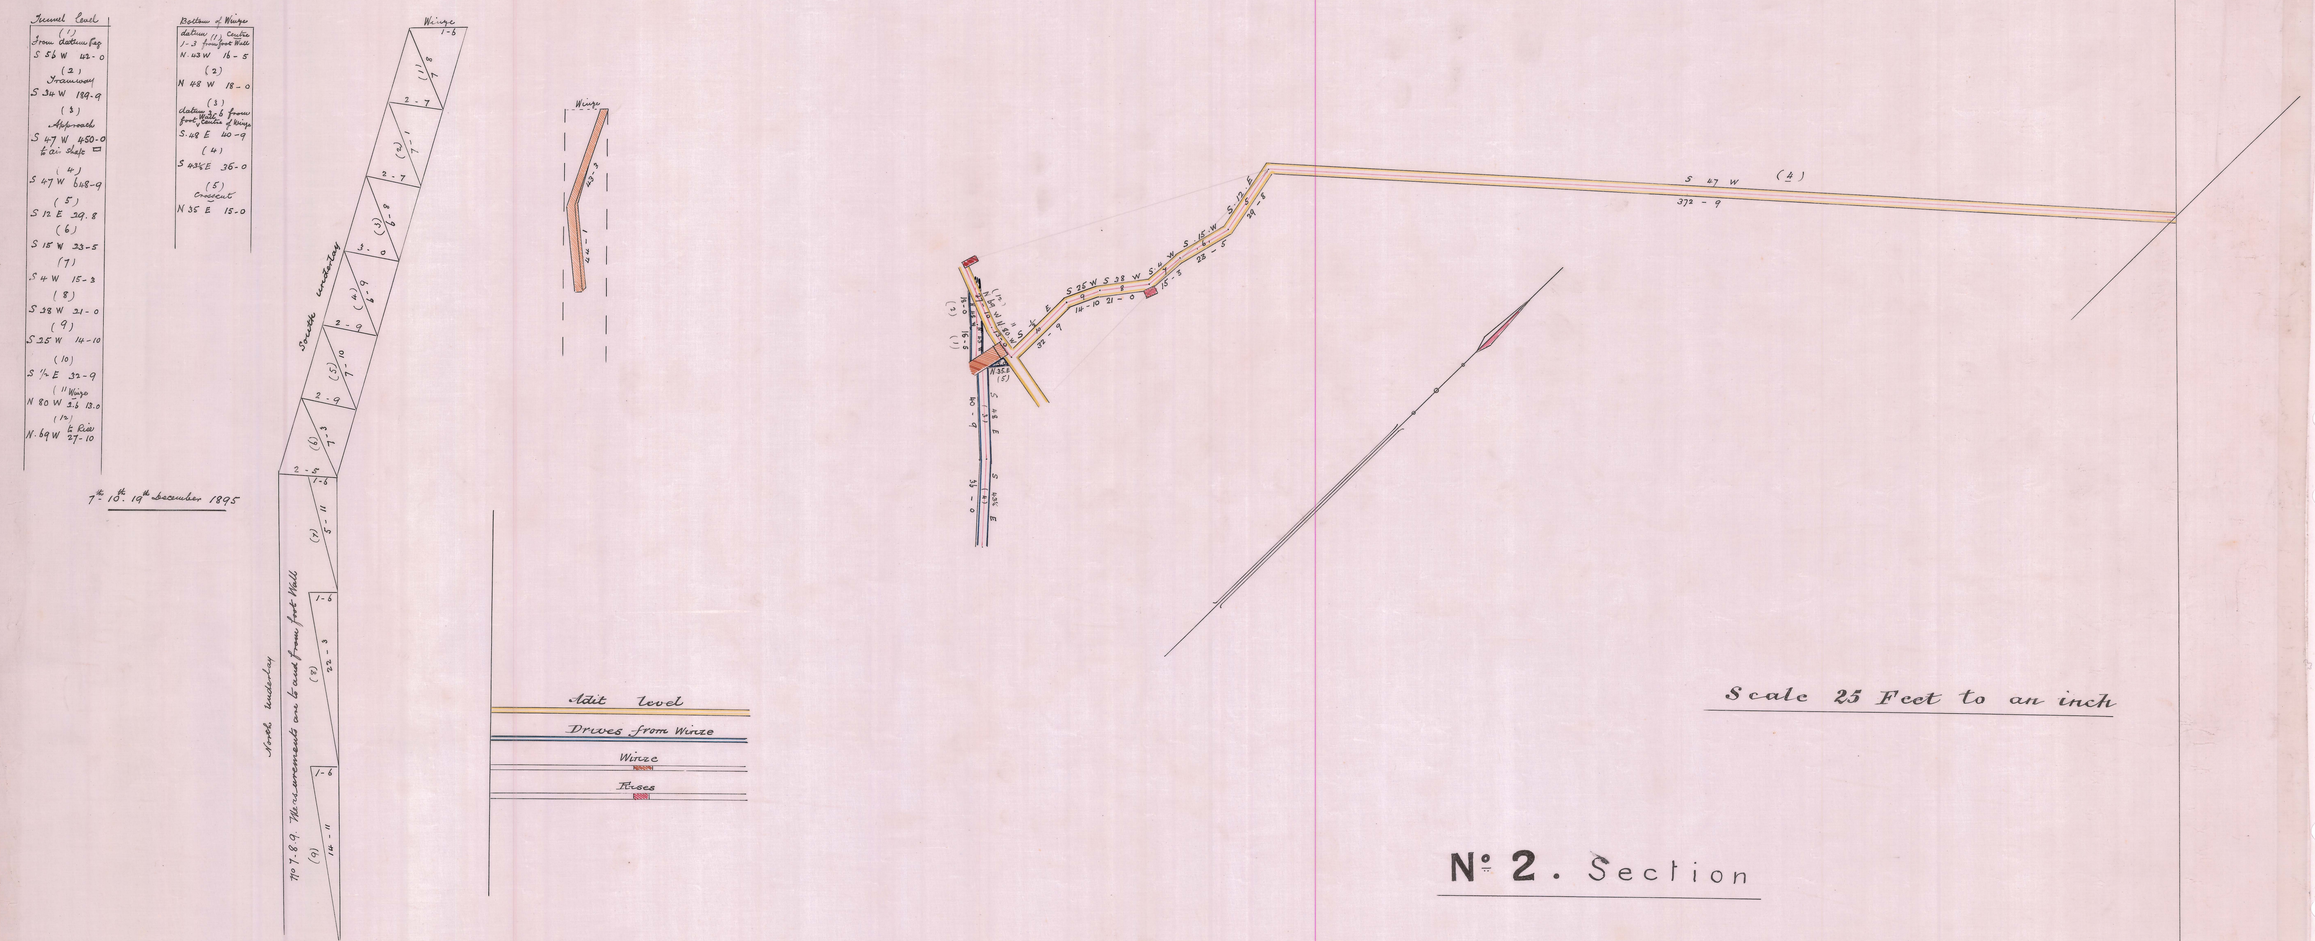

(signed) G. L. Buggard
certificated Mining Manager

No 2. Section

270-03

270-03