


278-01


M^T HEEMSKIRK TMC^{OR}

SECTIONS OF WORKINGS

SCALE 100 FEET TO 4 INCHES

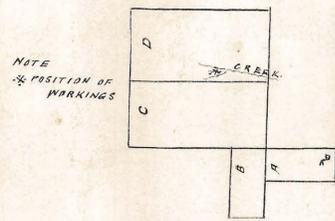

278-01

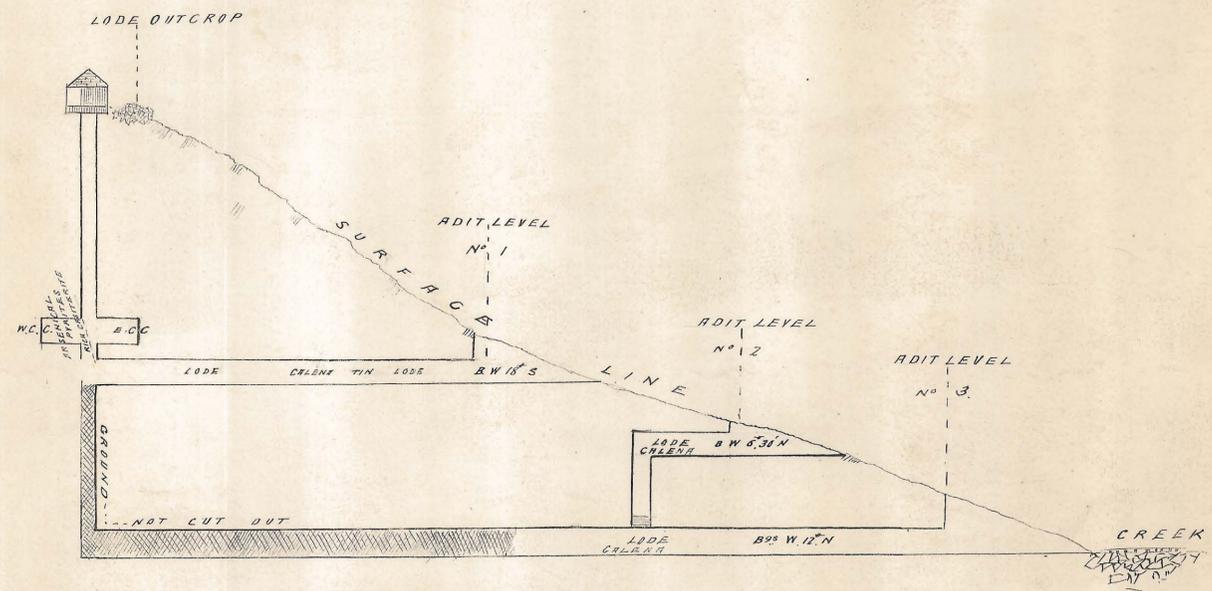

5 cm

J.B. 2/13/03