



275-01

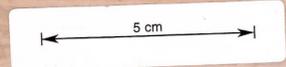


275-01


CURRIE & EVERESTS SHAFT

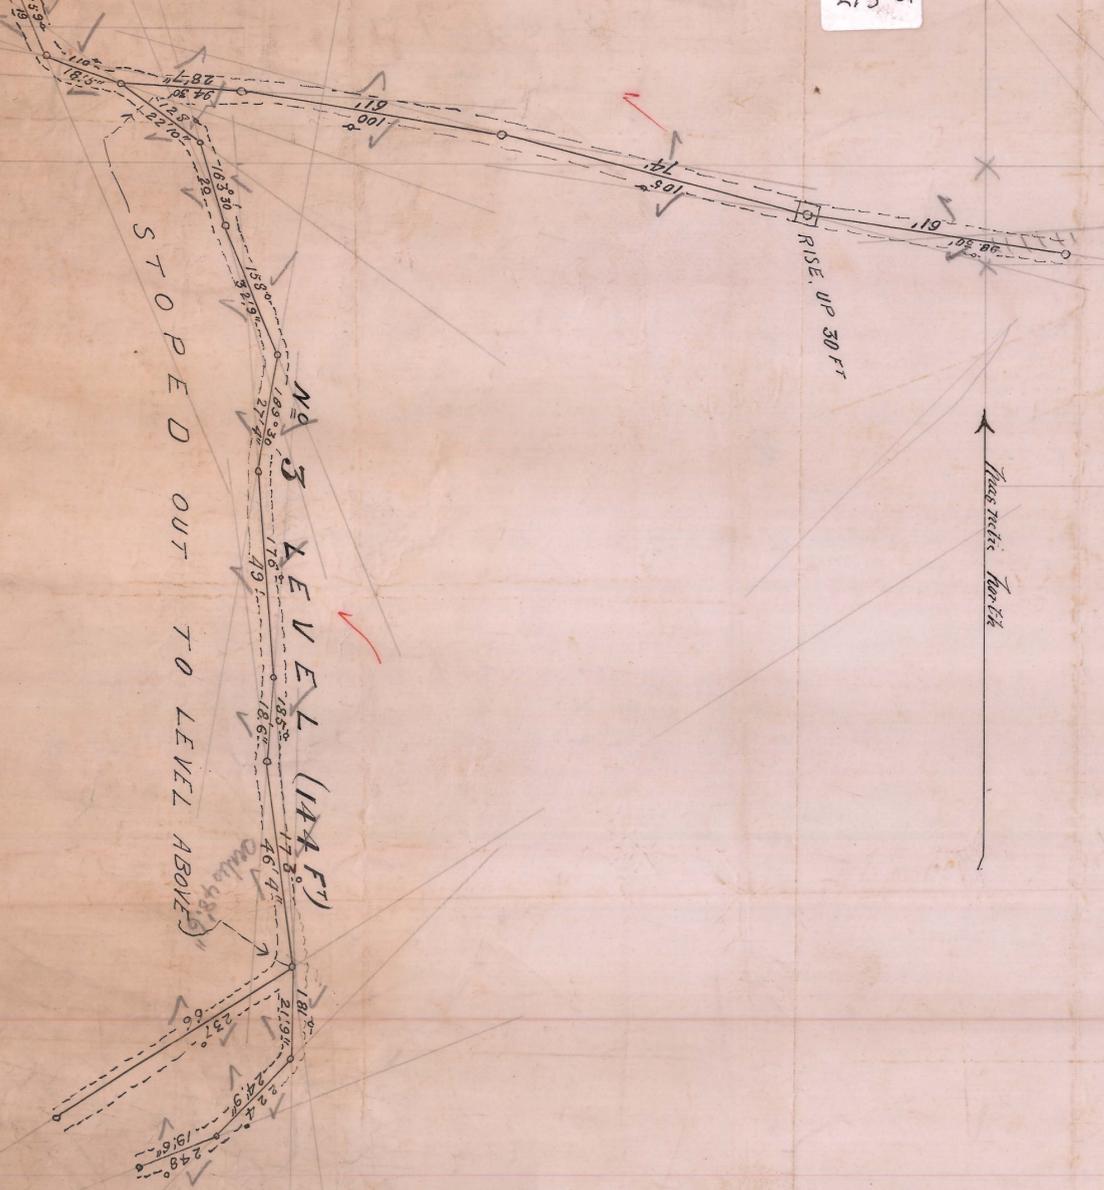

CURRIE & EVERESTS SHAFT

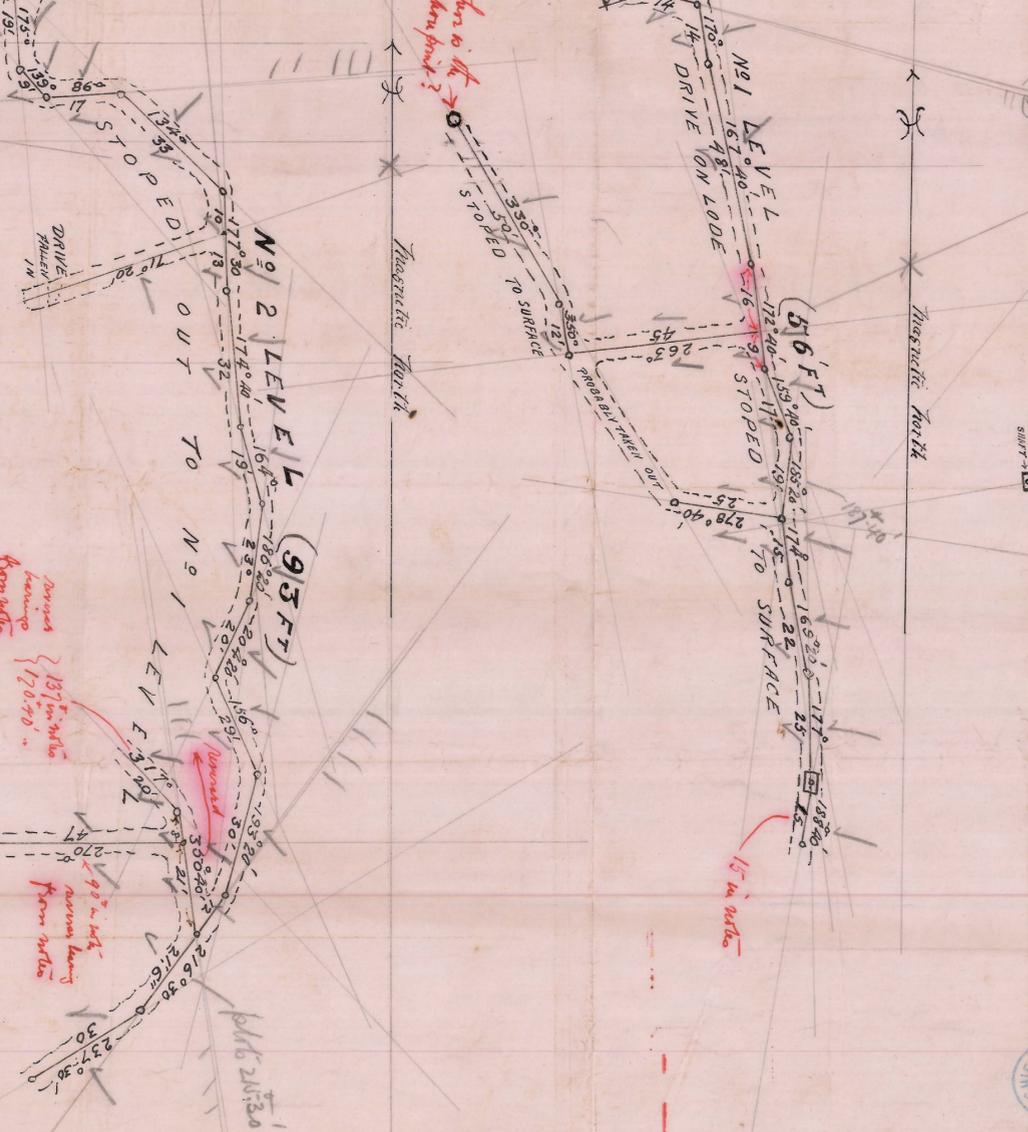


CURRIE & EVERESTS SHAFT

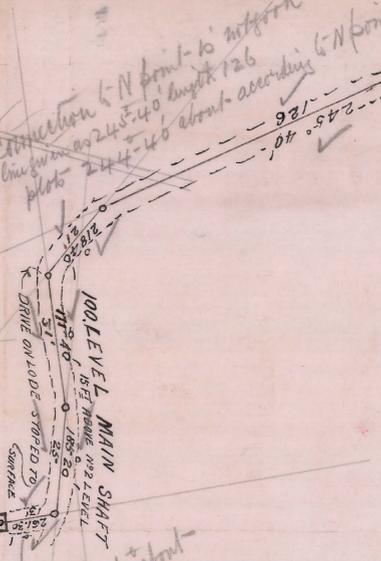

MAIN SHAFT

CURRIE & EVERESTS SHAFT

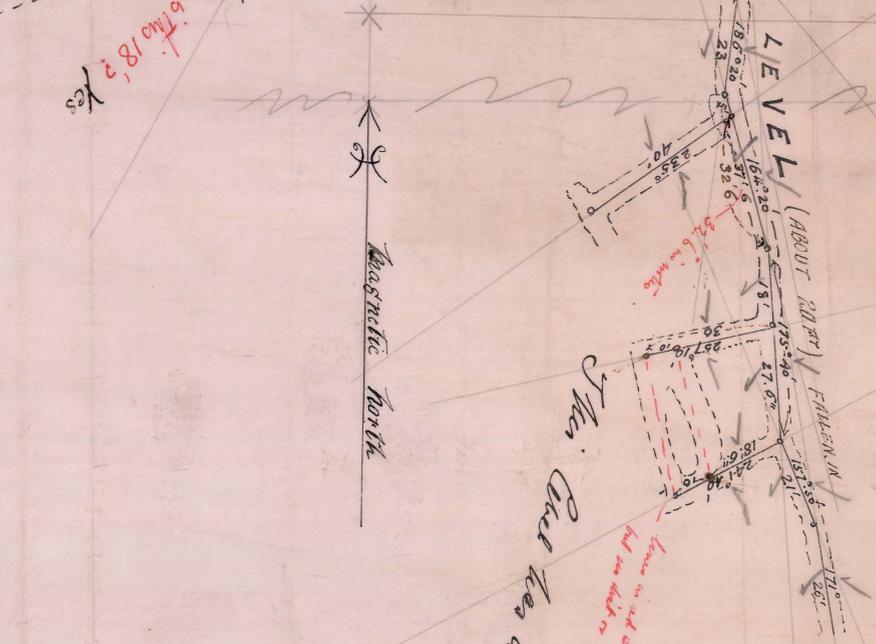

SCALE 25 FT TO 1 INCH

WR Sale

October 21st 1900



St. Mrs. Currier has at some point

27-6
18
45-6

88

88