



275-04

82

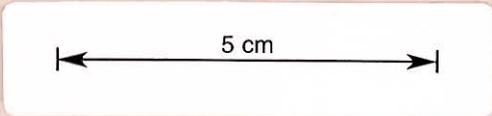

275-04

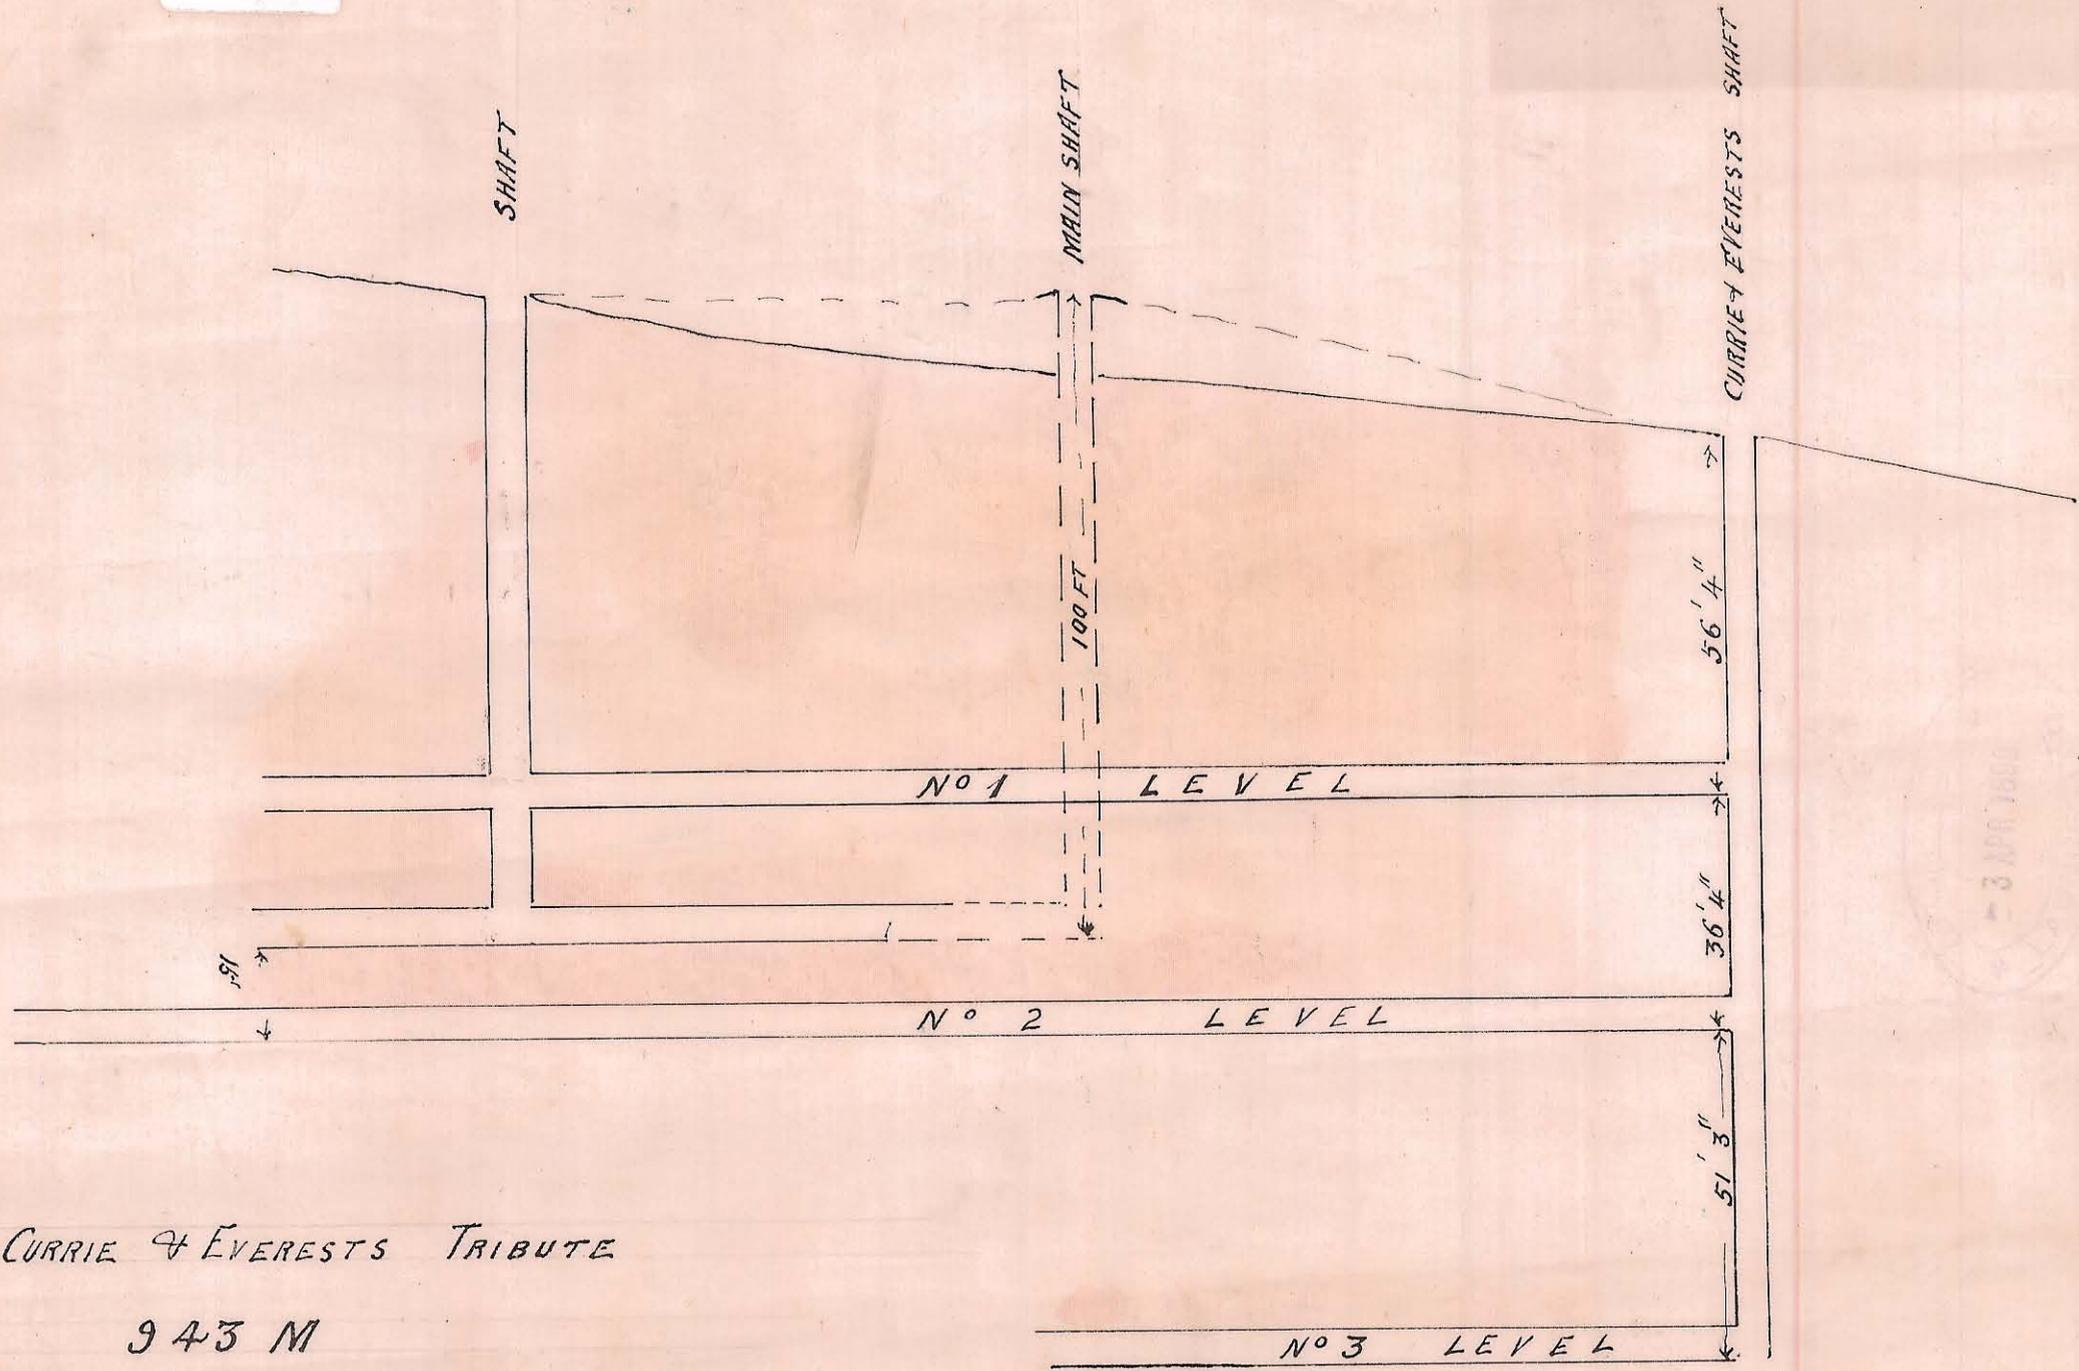

CURRIE & EVERESTS TRIBUTE

943 M

SECTION 30 FT TO AN INCH