



LONGITUDINAL SECTION

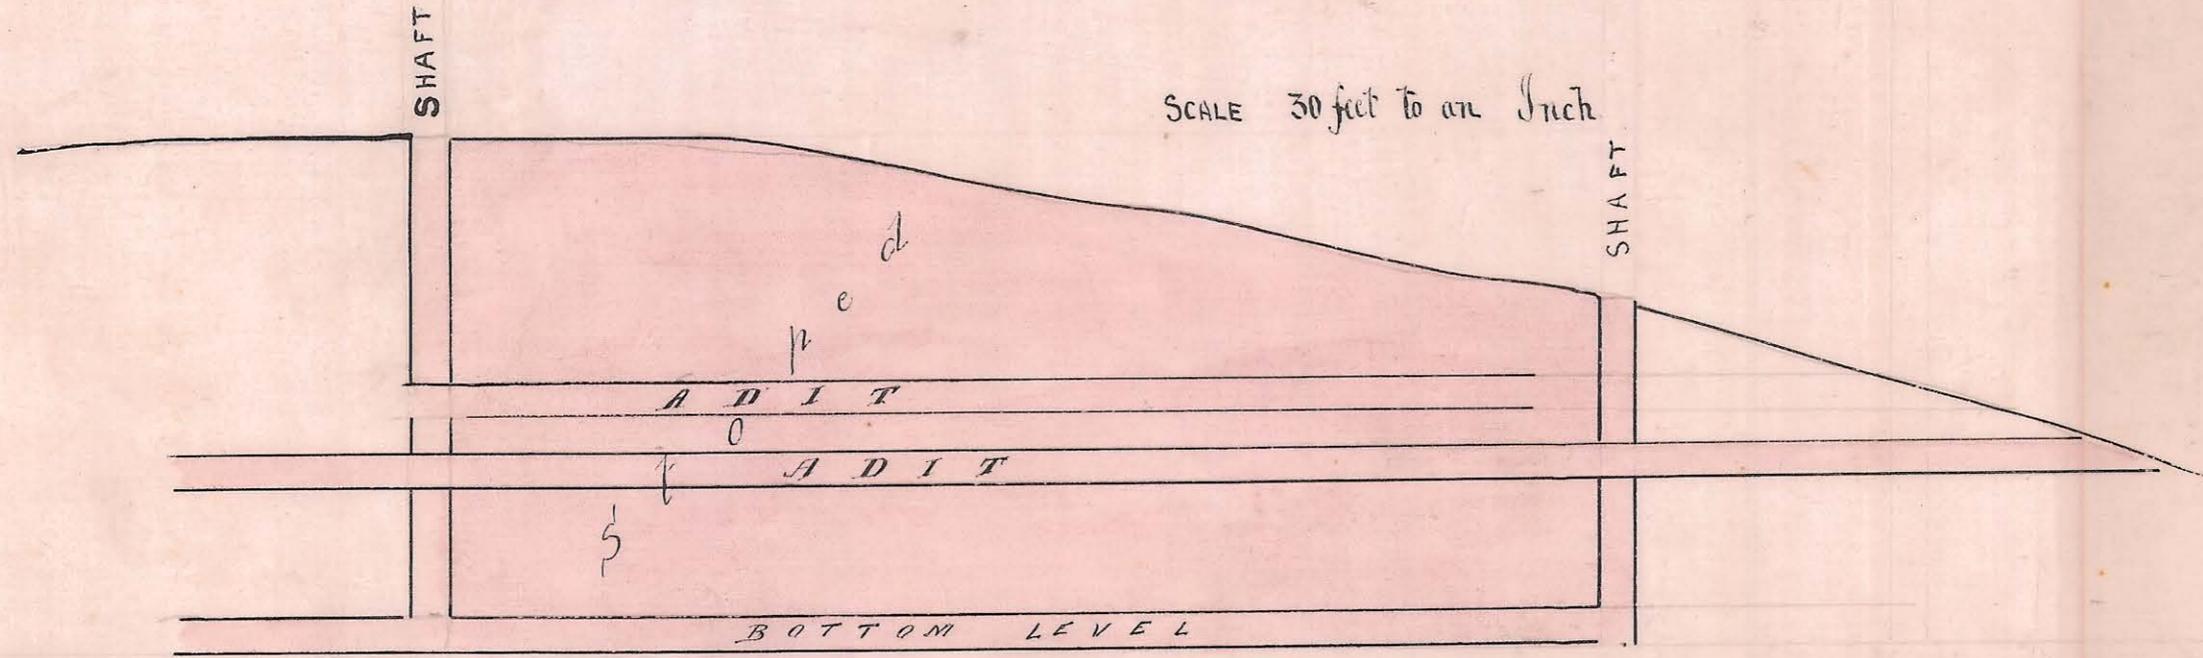

275-05

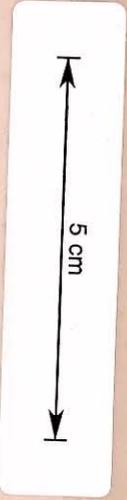

275-05

28