Mt. Pye Tinfe.
Mar. 1894

REX HILL TIN MINING COMPANY

Showing Method by which Outlines of Workings are found

Scale 10 feet to One inch

I hereby Certify this Plan to be Correct

Surveyed and Drawn by S. E. Richards
Mng Mgr.

March 20/94

INSPECTOR OF MINES OFFICE
27th March 1894.
LAUNCESTON

280-02
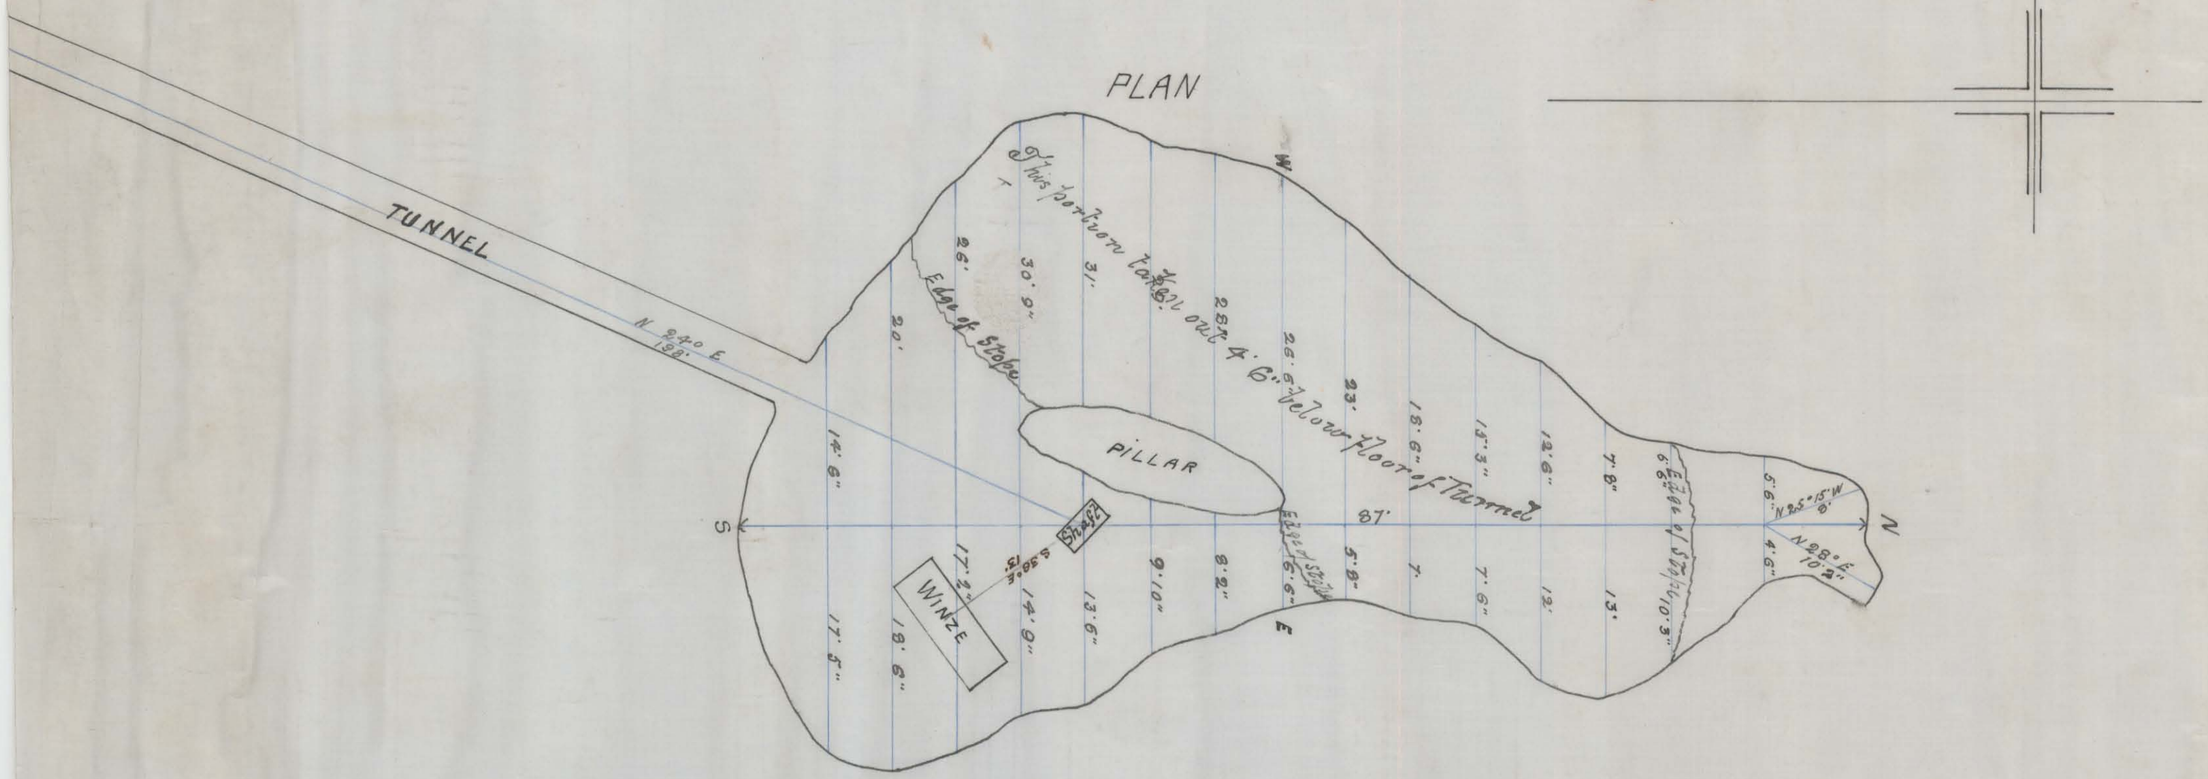
280-02