


Cor. Peg. 3 should be
1140 ft. farther East. 972. Plan
P-71

Cor. Peg. should be
1141 feet farther
South on Plan.
Sealed from Govt.
1914-15

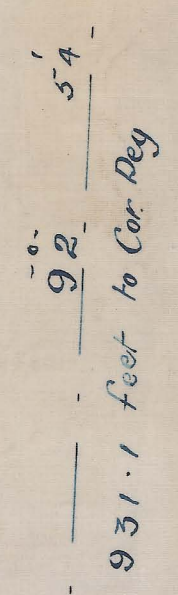

Luke Williams
Carey W. M.
Dec 31st 1900

RECEIVED
2 FEB 1901

2

183