RING VALLEY M.Co LTD.

Plan of Workings, etc:

Scale

1 inch to 25 fs.

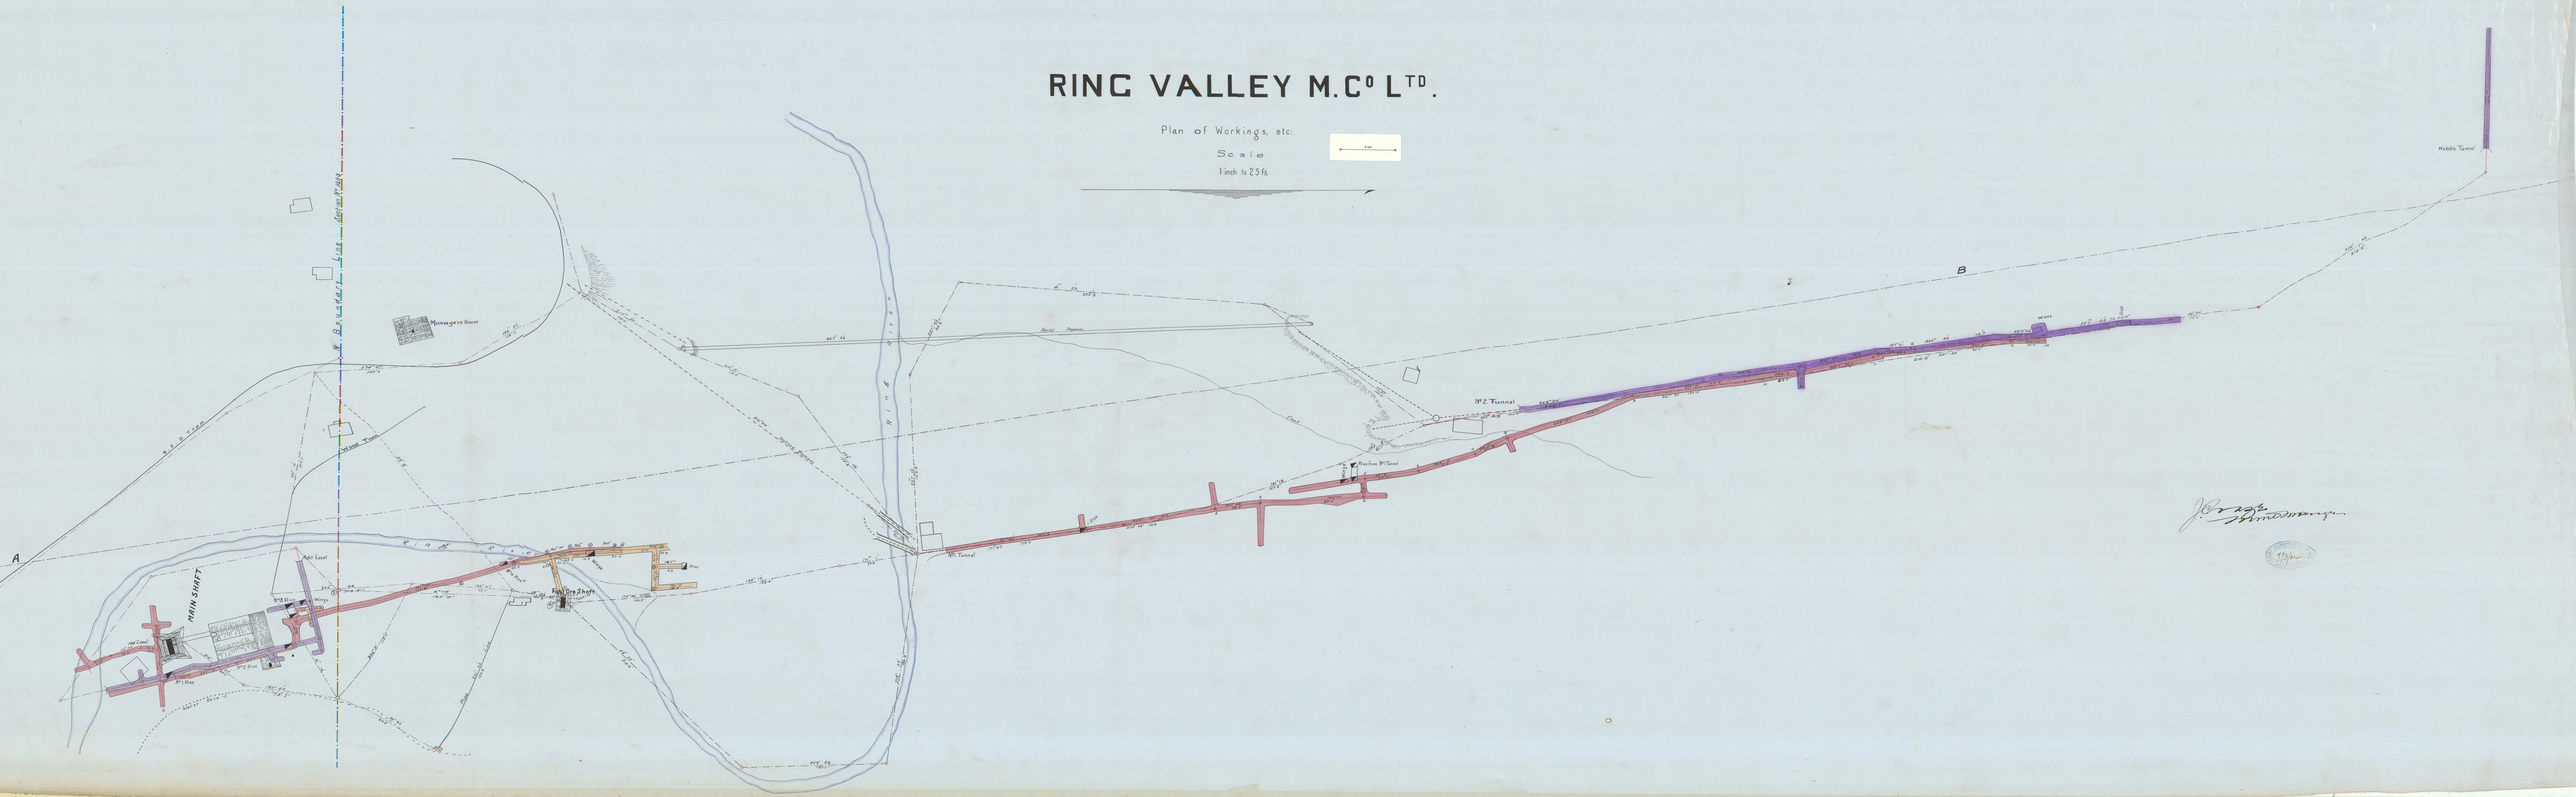

J. Bragg
Manager

19/4/94