THE ROUND HILL S & L M Co. N L

PLAN

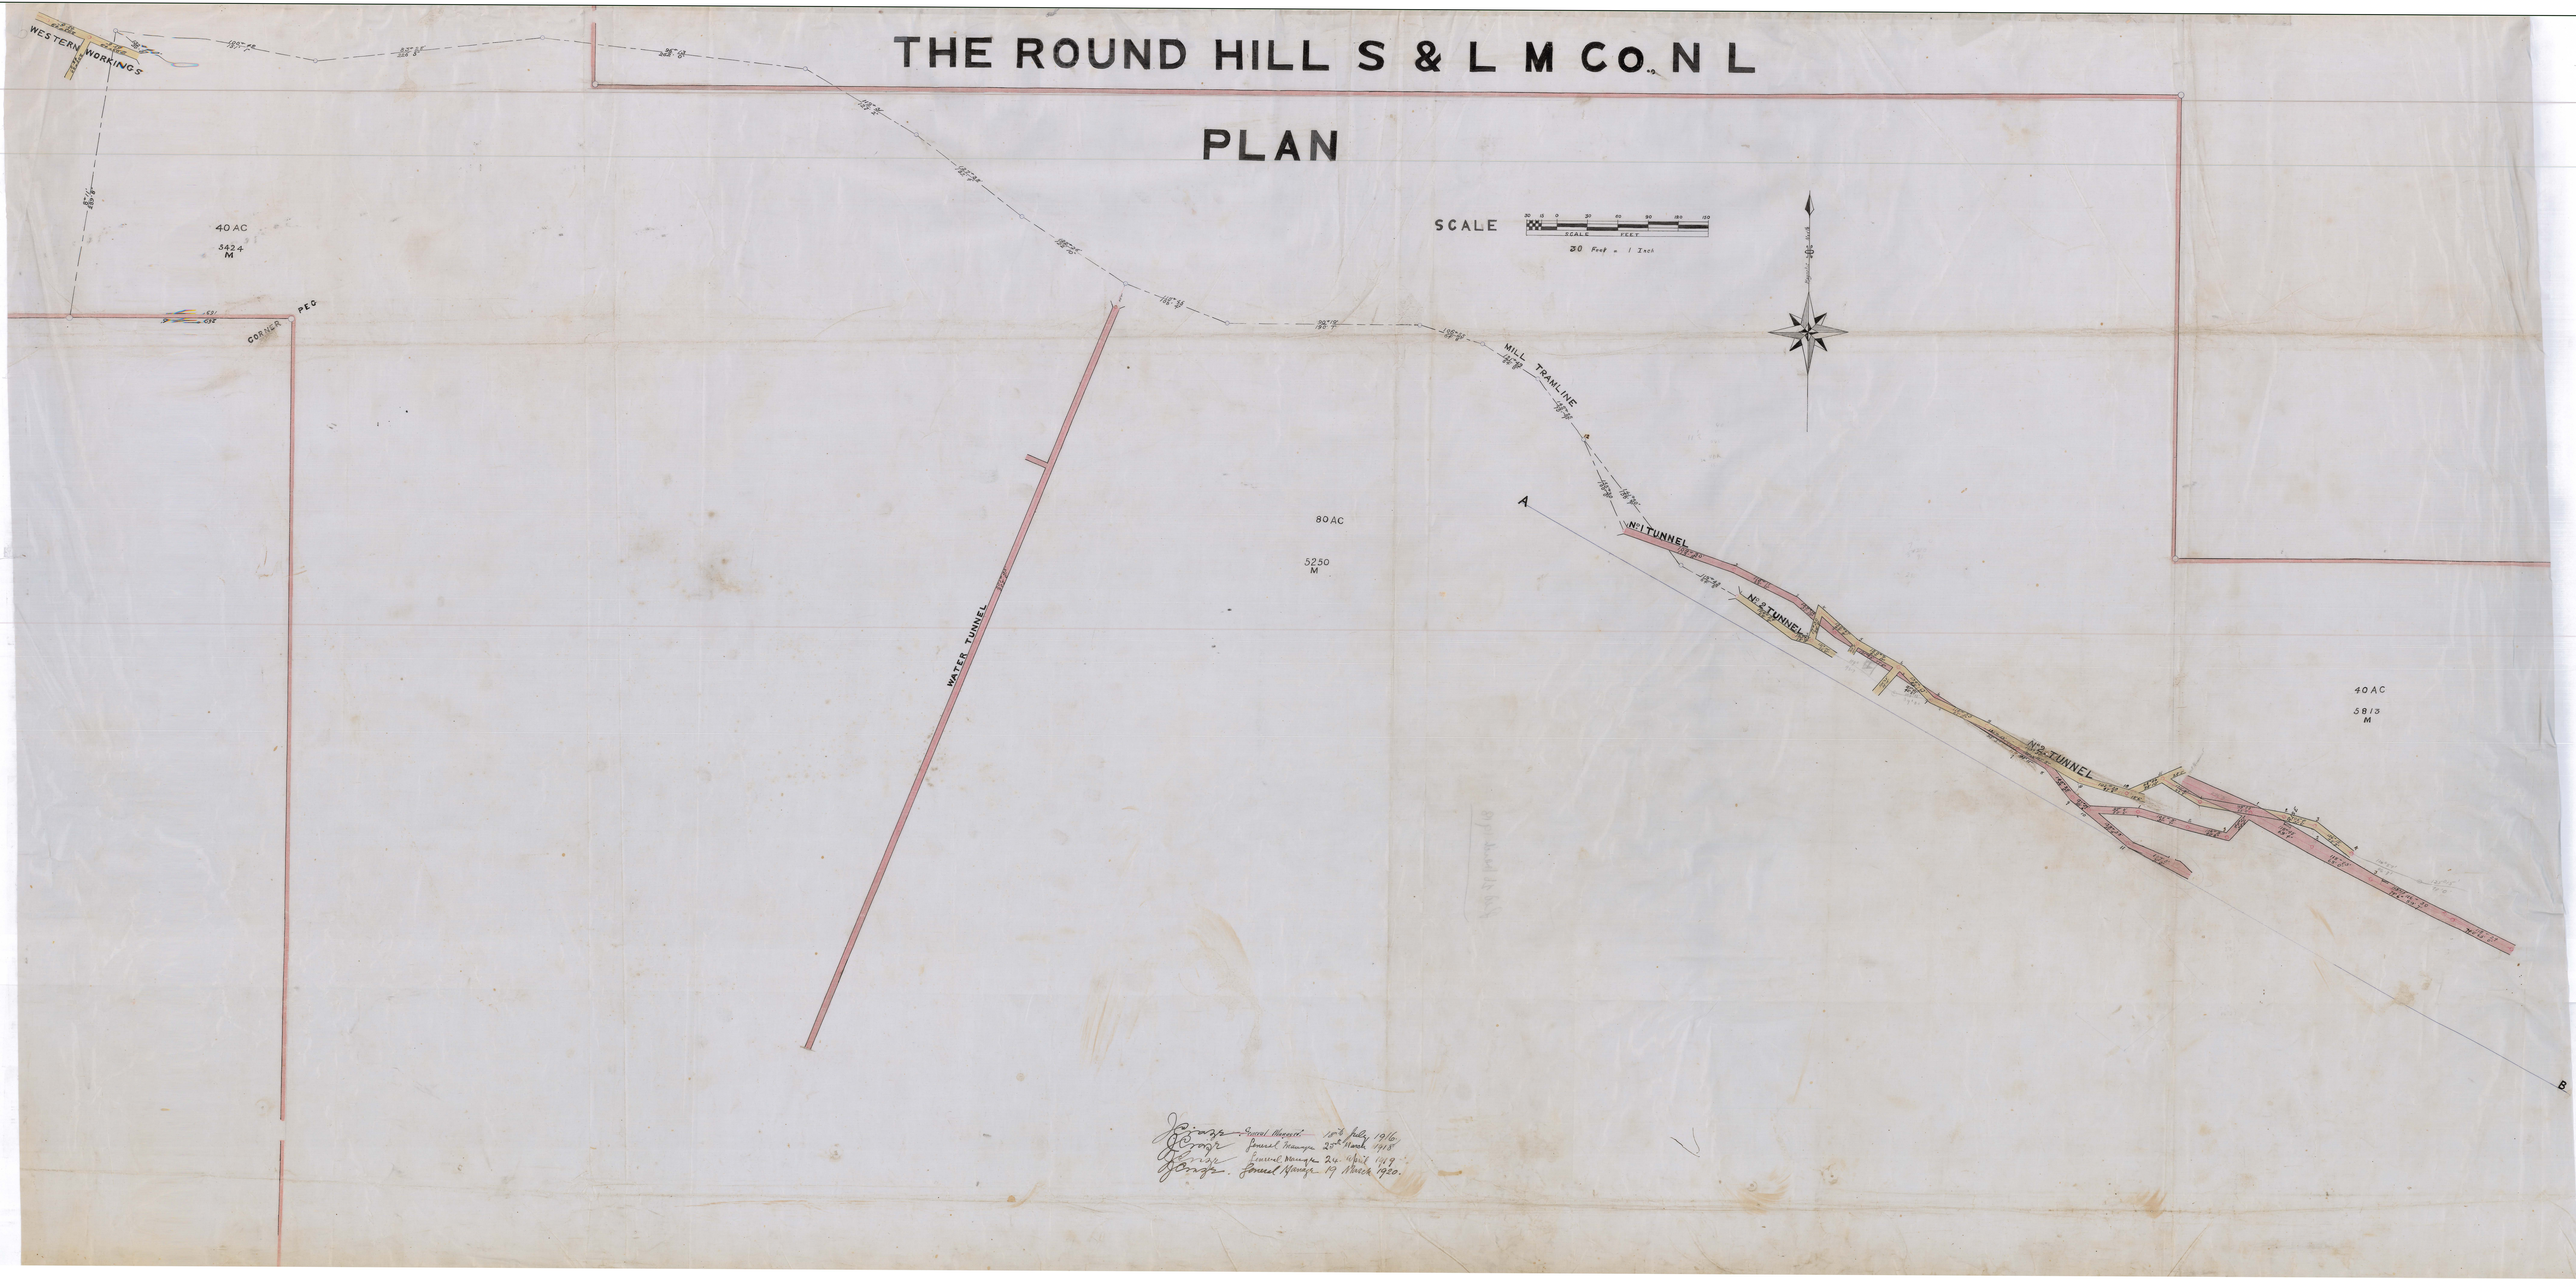

Lowell Mangin 1st July 1916
Lowell Mangin 20th March 1918
Lowell Mangin 24 April 1919
Lowell Mangin 19 March 1920.