



THE ROUND HILL S & L M Co., N L

SECTION ON LINE A.B.

SCALE



30 Feet = 1 Inch

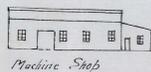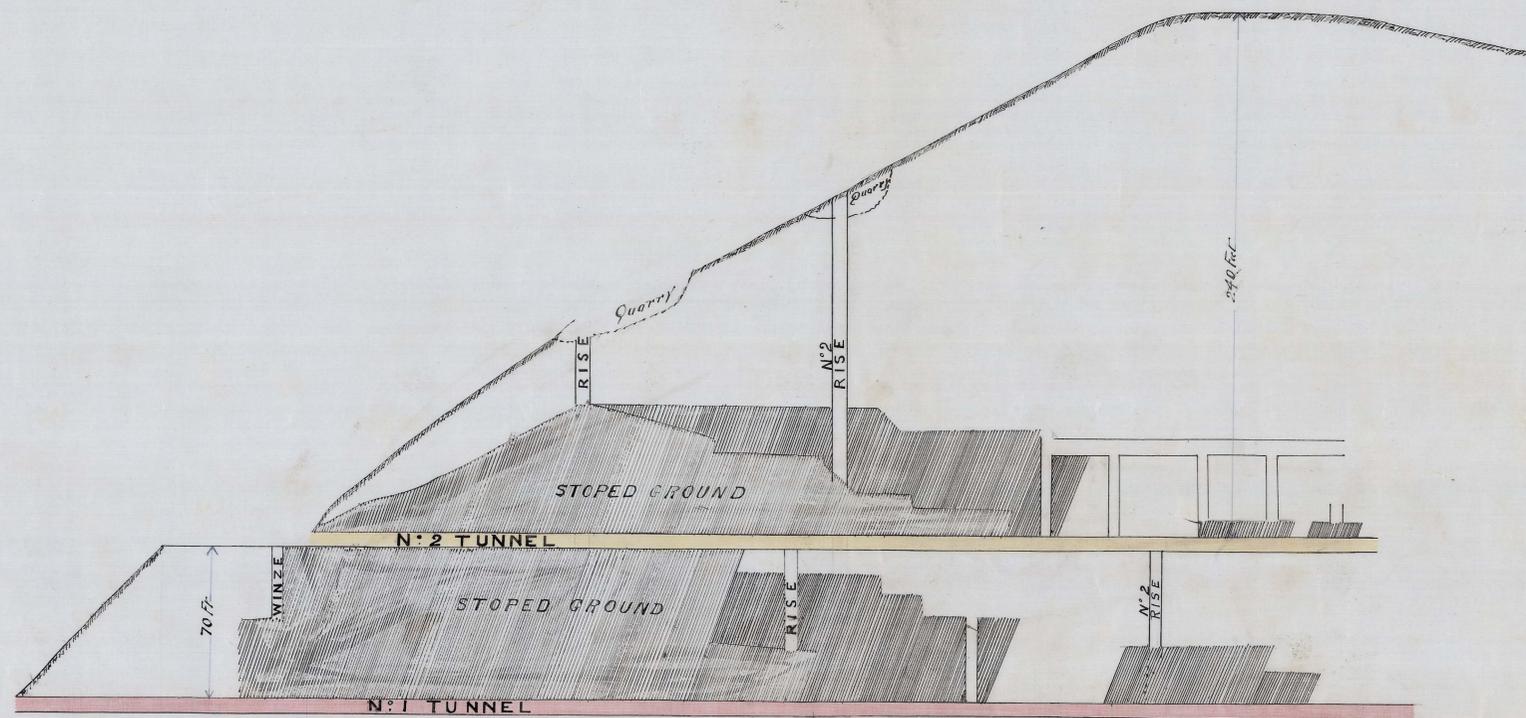

5 cm