Plan
Year 1894

The Silver King Prospecting Association Zeehan

30th March 1895
LAUNCESTON

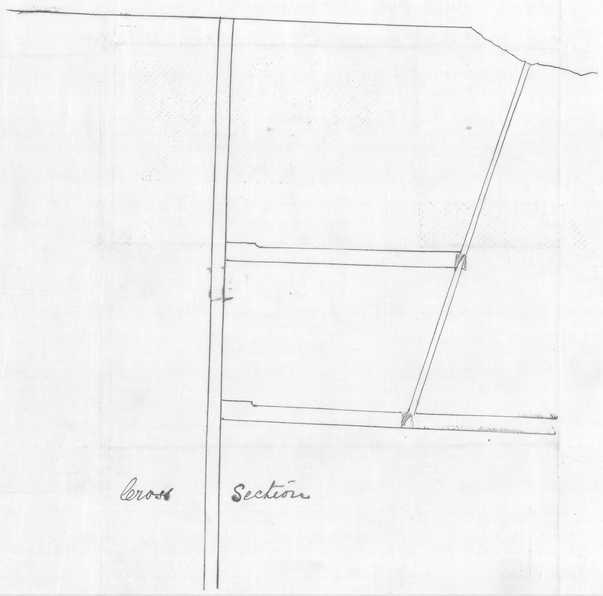

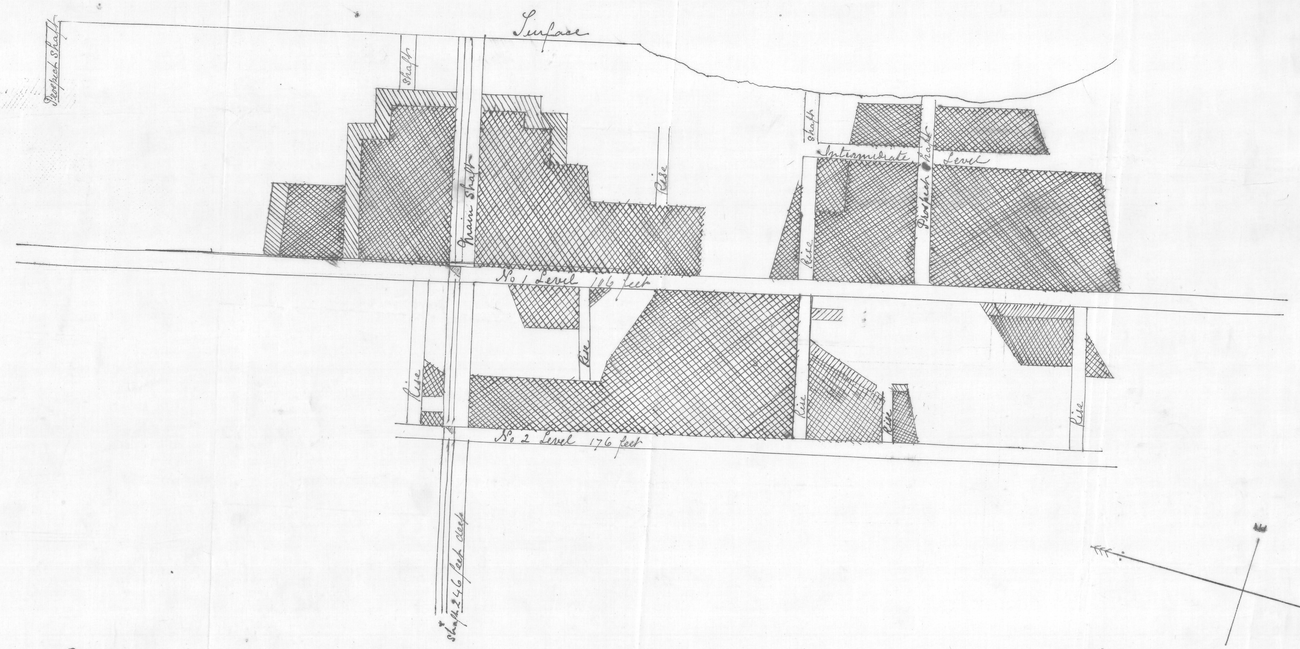

Scale
25 Feet To One Inch

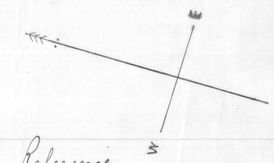
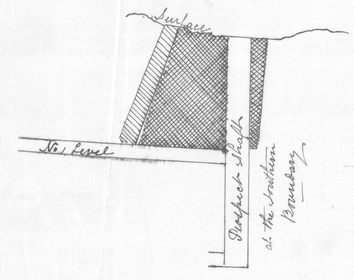
Reference
Ground Stoped
Stoped Filled in