# THE
# SILVER KING P.A.

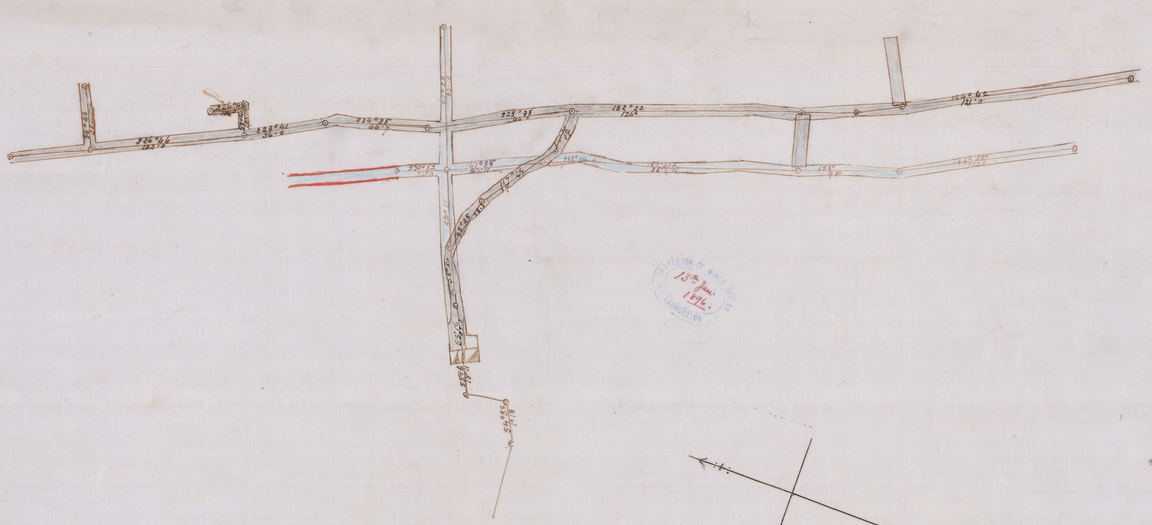

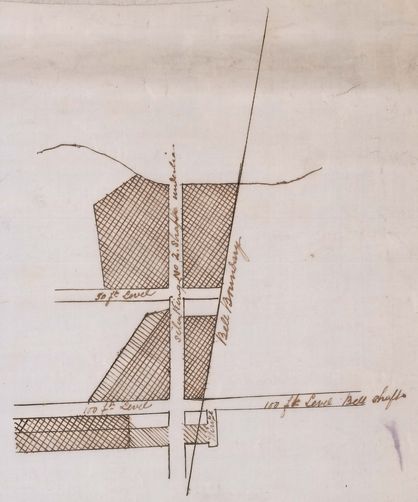


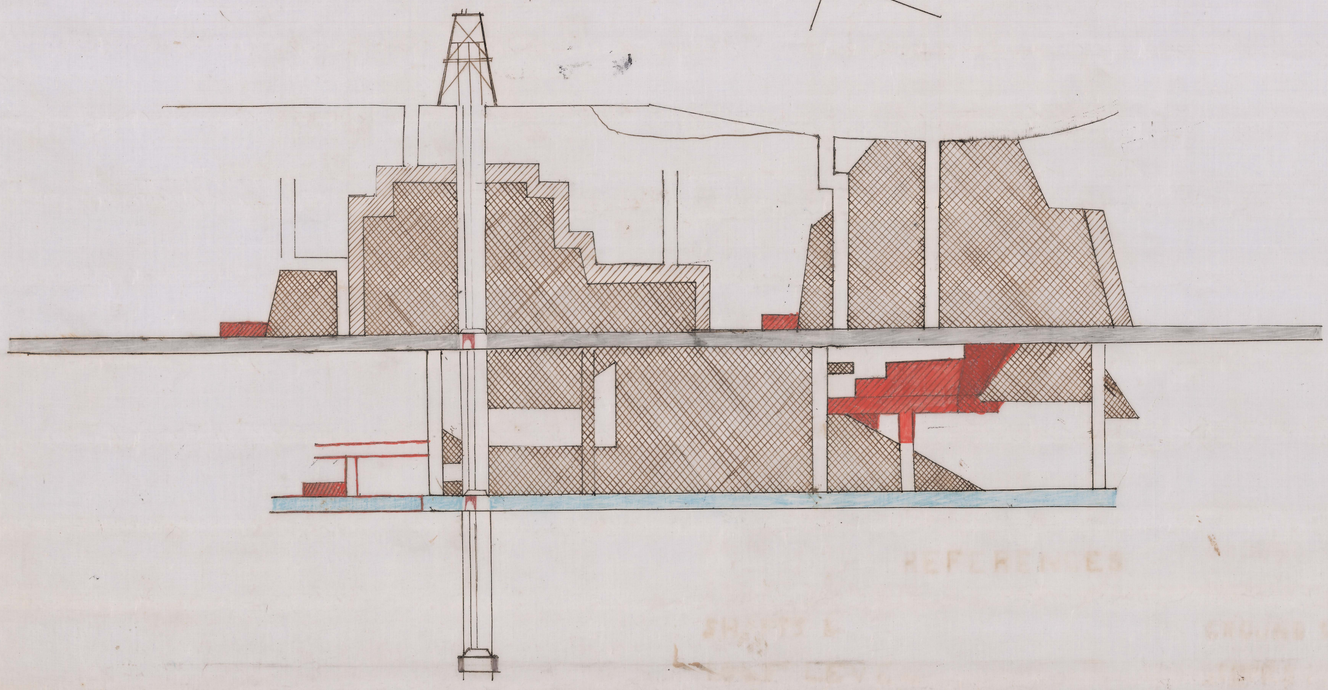

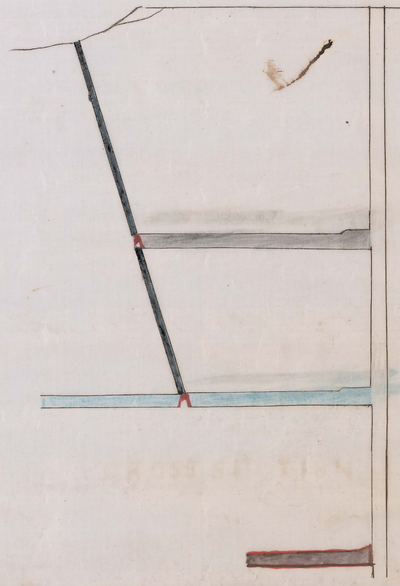

CROSS SECTION

## REFERENCES

- SHAFTS &
- 106 FT LEVEL
- 176 FT "
- 246 FT "
- GROUND STOPED
- STOPES FILLED IN
- LODE
- NEW WORKS

SCALE 25 FT 1 INCH

Drawn by Thomas Hughes December 30th 1895

INSPECTOR OF MINES SOUTH AUSTRALIA 13th Jan. 1896 CHIEF INSPECTOR