

No.	28	29	30
Length	5'	5'	15'
Pb %			
Ag oz/t			

Open Cut.

828
Dump

No.	31	32	33	14	15	16	17
Length	5'	5'	5'	5'	5'	4'	
Pb %				34	15	19	22
Ag oz/t				11	4	7	6

No.	34	33	12	11	10	9
Length	5'	5'	5'	5'	5'	5'
Pb %				36	19	35
Ag oz/t				18	12	19


No.	18	19	20	21	94	93	92
Length	5'	5'	5'	2'	3'	5'	5'
Pb %	23	15	0	1	16	38	48
Ag oz/t	37	23	0	2	0	3	10

No.	3	4	5	95	96	97	98	99
Length	5'	5'	5'	5'	5'	5'	5'	5'
Pb %	28	14	17	22	19	25	13	36
Ag oz/t	12	3	11	5	17	28	35	33

No.	6	7	8	1	2
Length	5'	5'	5'	28	29
Pb %	22	4	1	26	26
Ag oz/t	12	1	18	20	36

No.	91	90	89	88	87	86	85
Length	5'	5'	5'	5'	5'	5'	5'
Pb %	22	57	13	09	17	05	19
Ag oz/t	12	1	27	25	24	10	10

No.	79	78	77	76
Length	5'	5'	5'	5'
Pb %	50	24	51	64
Ag oz/t	16	2	10	6

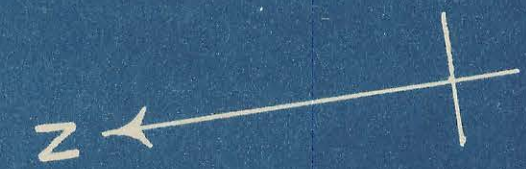

Winch-house
Excavation
Main Shaft

No. 3 D.D. Hole
Vertical

No. 2 D.D. Hole
Dip 80° E.

No. 1 D.D. Hole
Dip 75° E.


West Coast Mine?

West Coast Mine

Surface Plan

SCALE: 1 IN = 40 FT

X24-

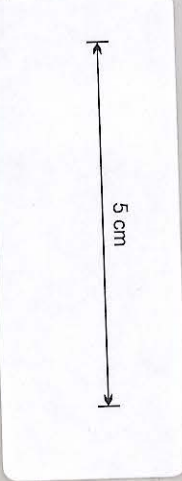

0292-008