Section No 1486/m 40-A

Felix Burns

Mount Read

F. Clinnie
Zeehan
March 20th 07

Tunnel No 1

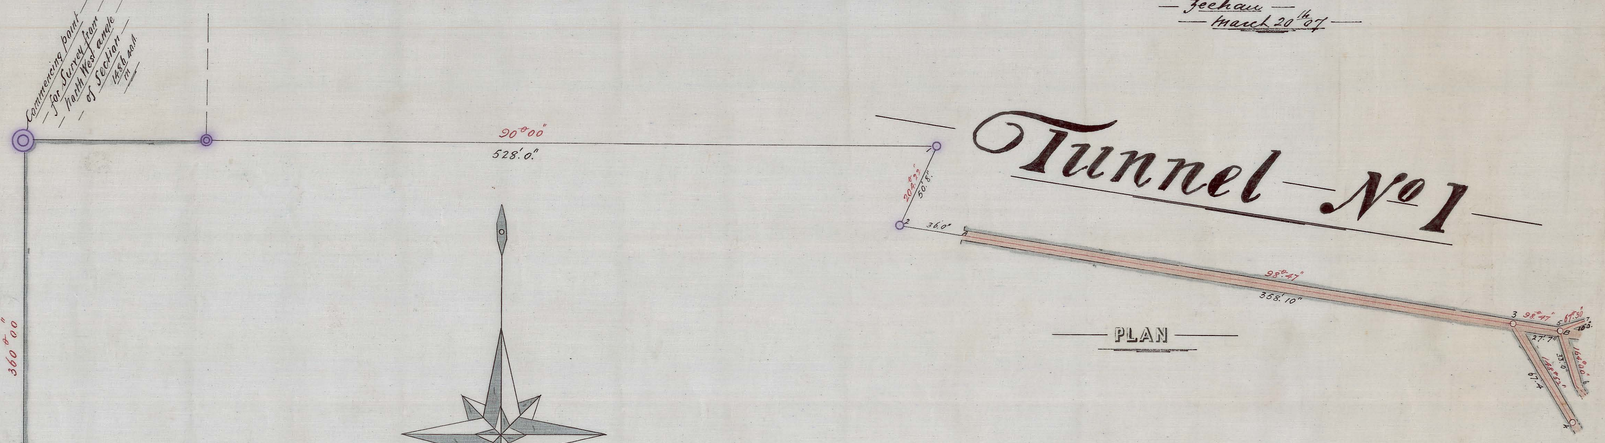

Scale 40 feet 1 inch

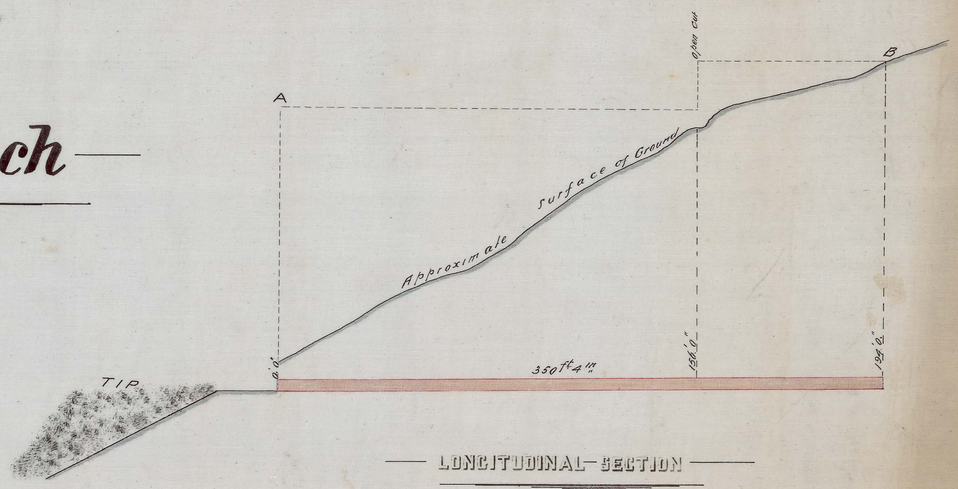

GOVERNMENT GEOLOGIST
22 MAR 1907
LAUNCESTON