


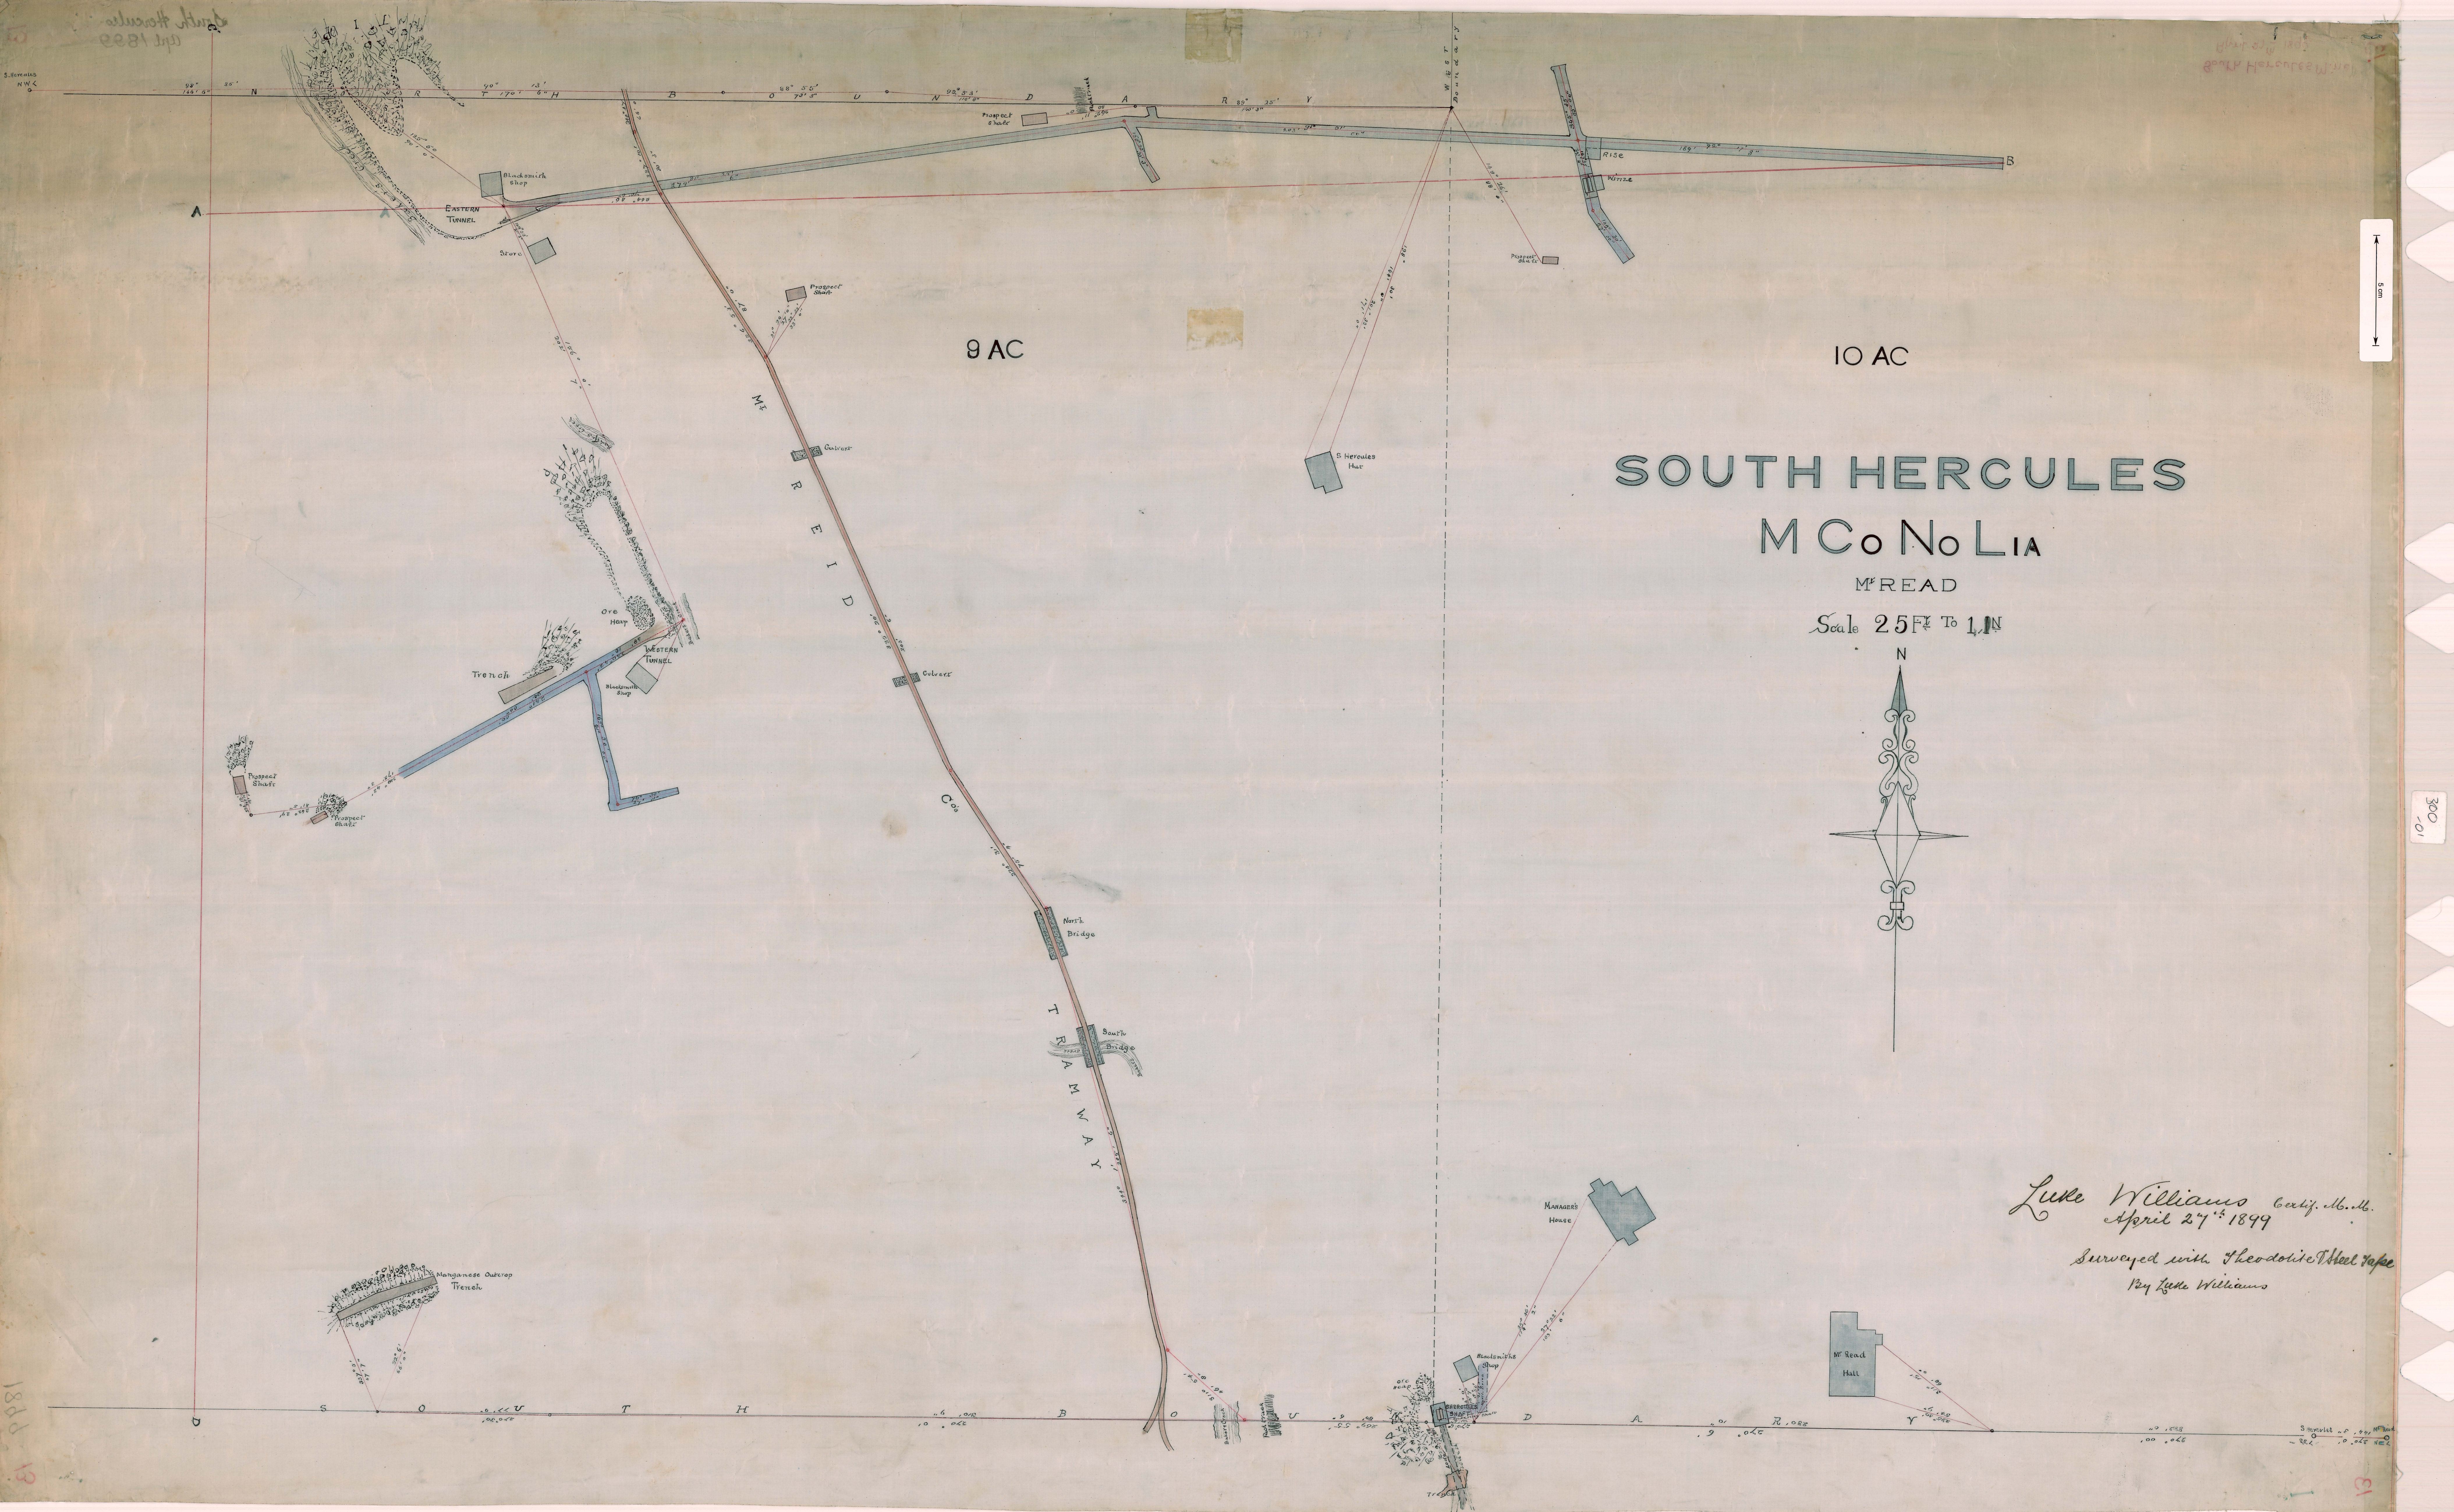


9 AC

10 AC

# SOUTH HERCULES M Co No LIA

M<sup>Y</sup> READ

Scale 25 FT To 1 IN

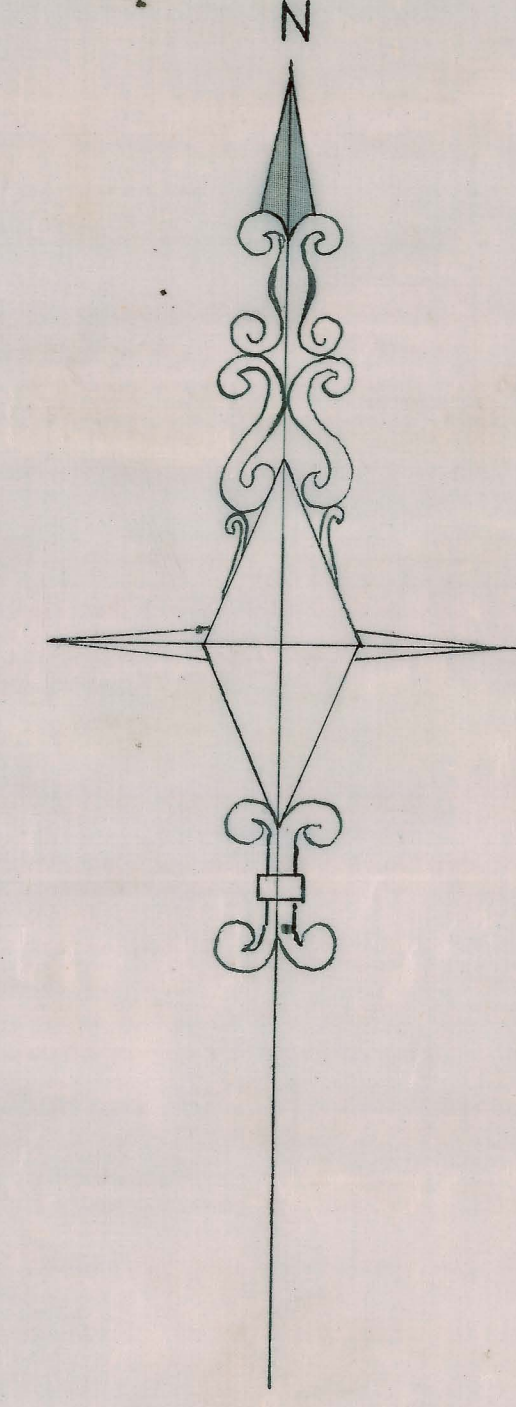

*Luke Williams Calif. M. M.  
April 27<sup>th</sup> 1899  
Surveyed with theodolite & steel tape  
By Luke Williams*



1888  
18

13