


30601


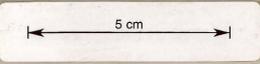


Plan of Barlen Hercules G.S. & C. Mining Coy.

PLAN

BARLEN-HERCULES G. S. & C. MINING COY

Scale 25 feet to an inch.

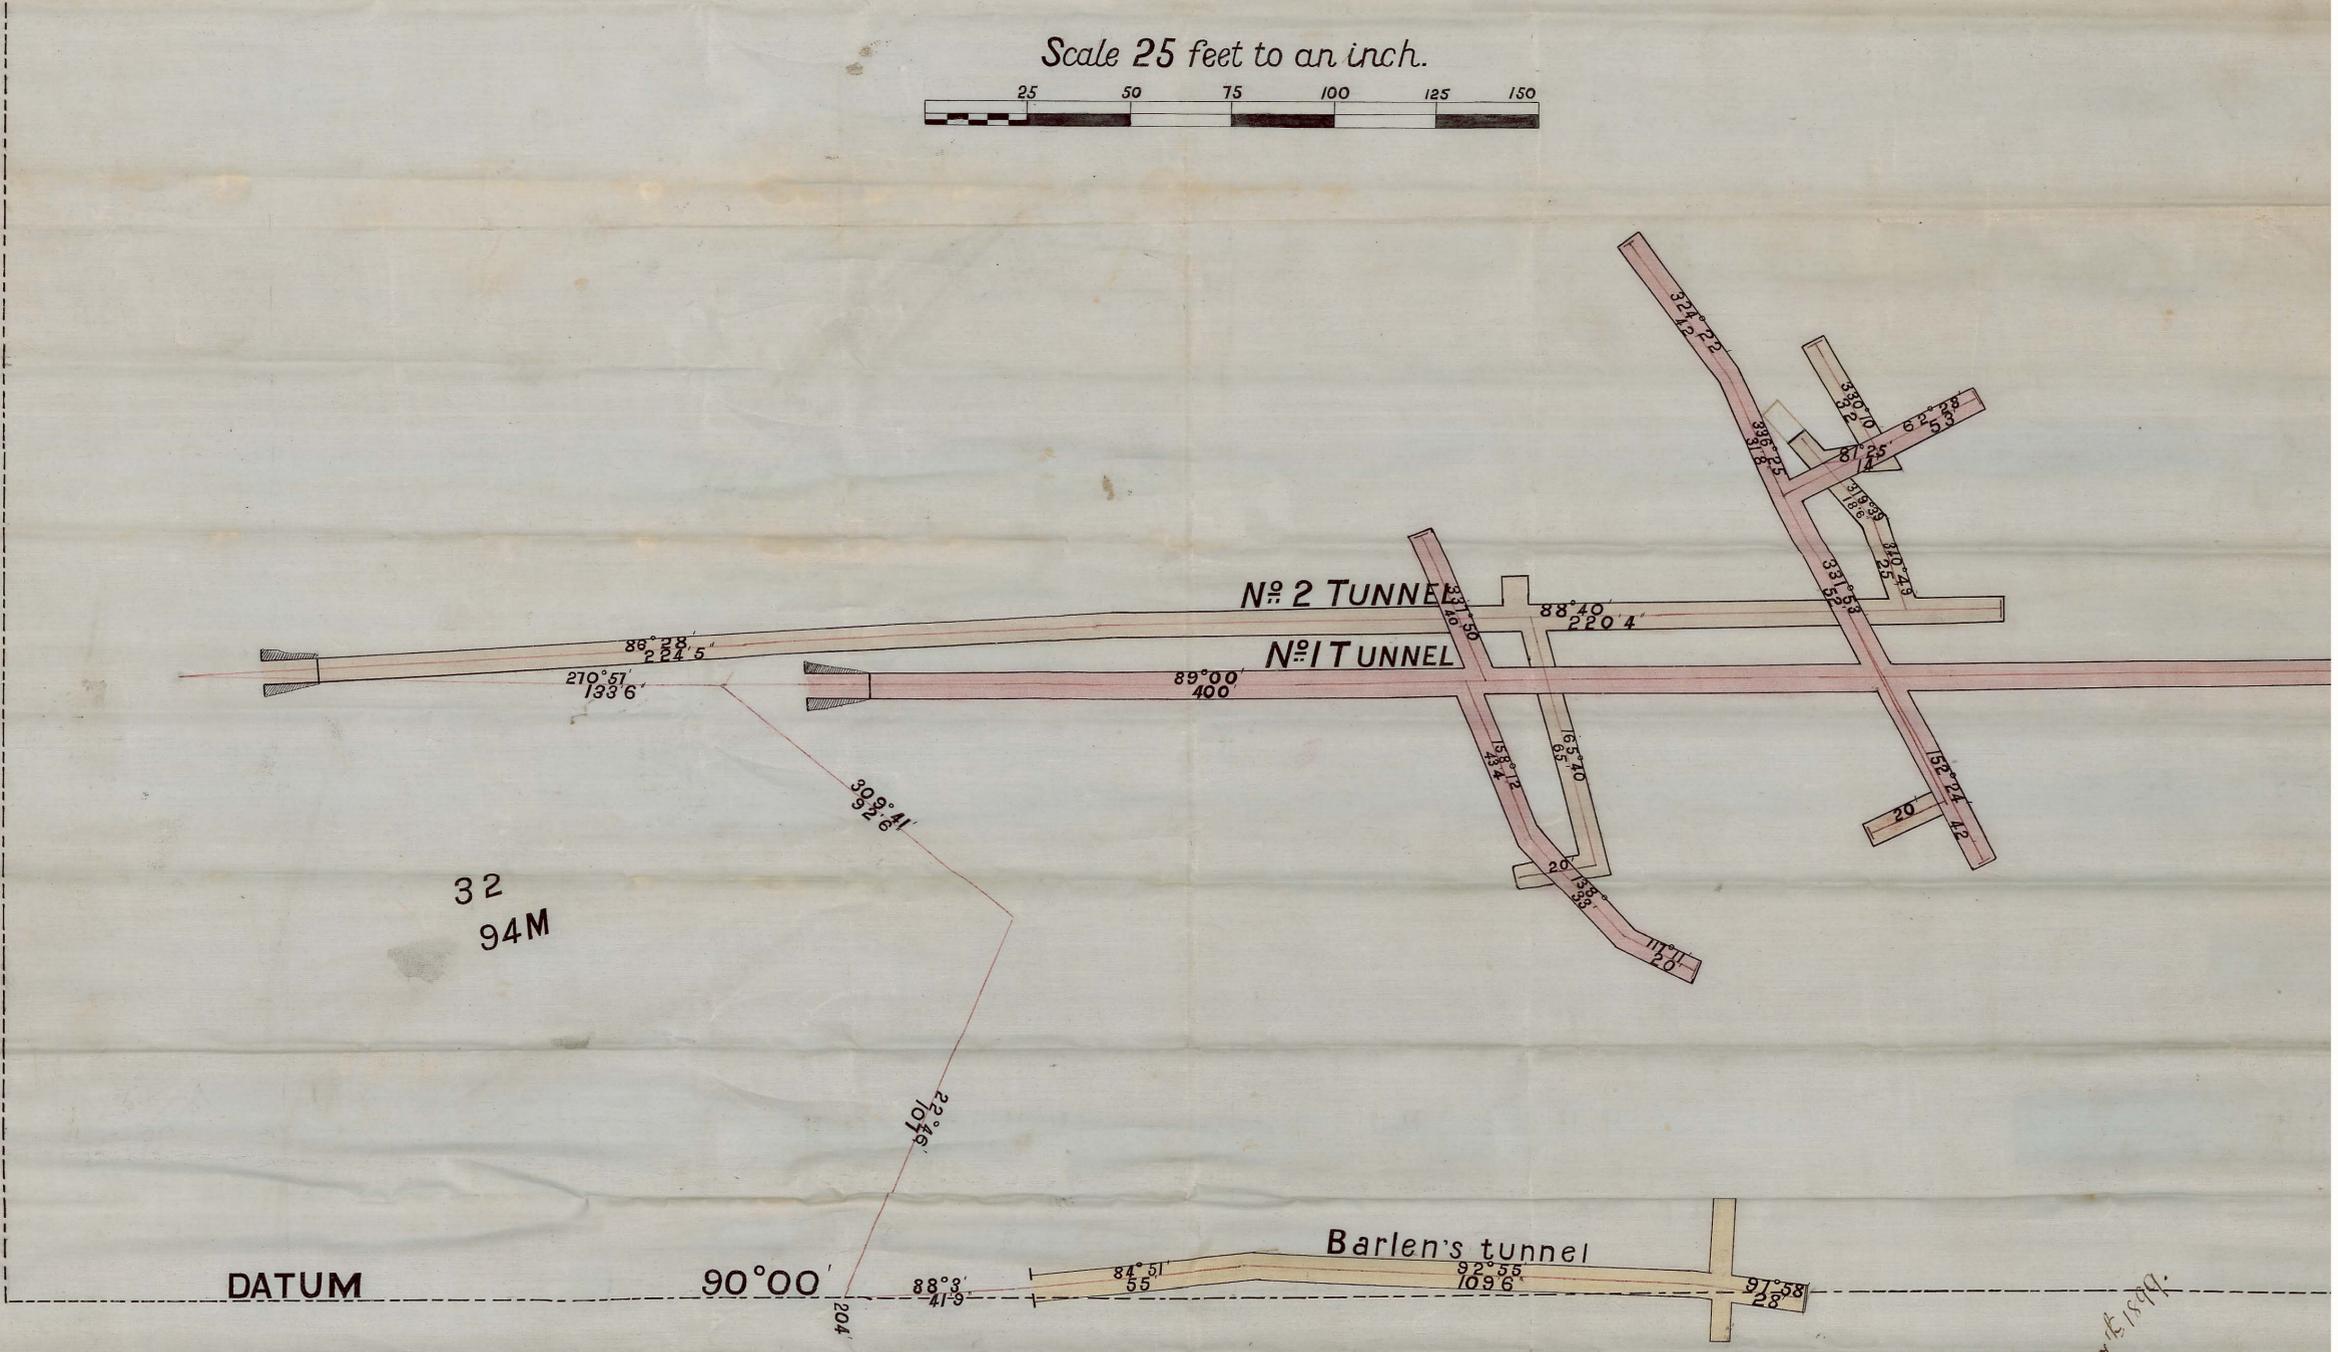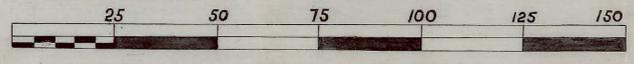

32
94M

*Barlen Hercules
Zelkhan. July 27th 1899.*