


5 cm

TAS COPPER COY LTD.

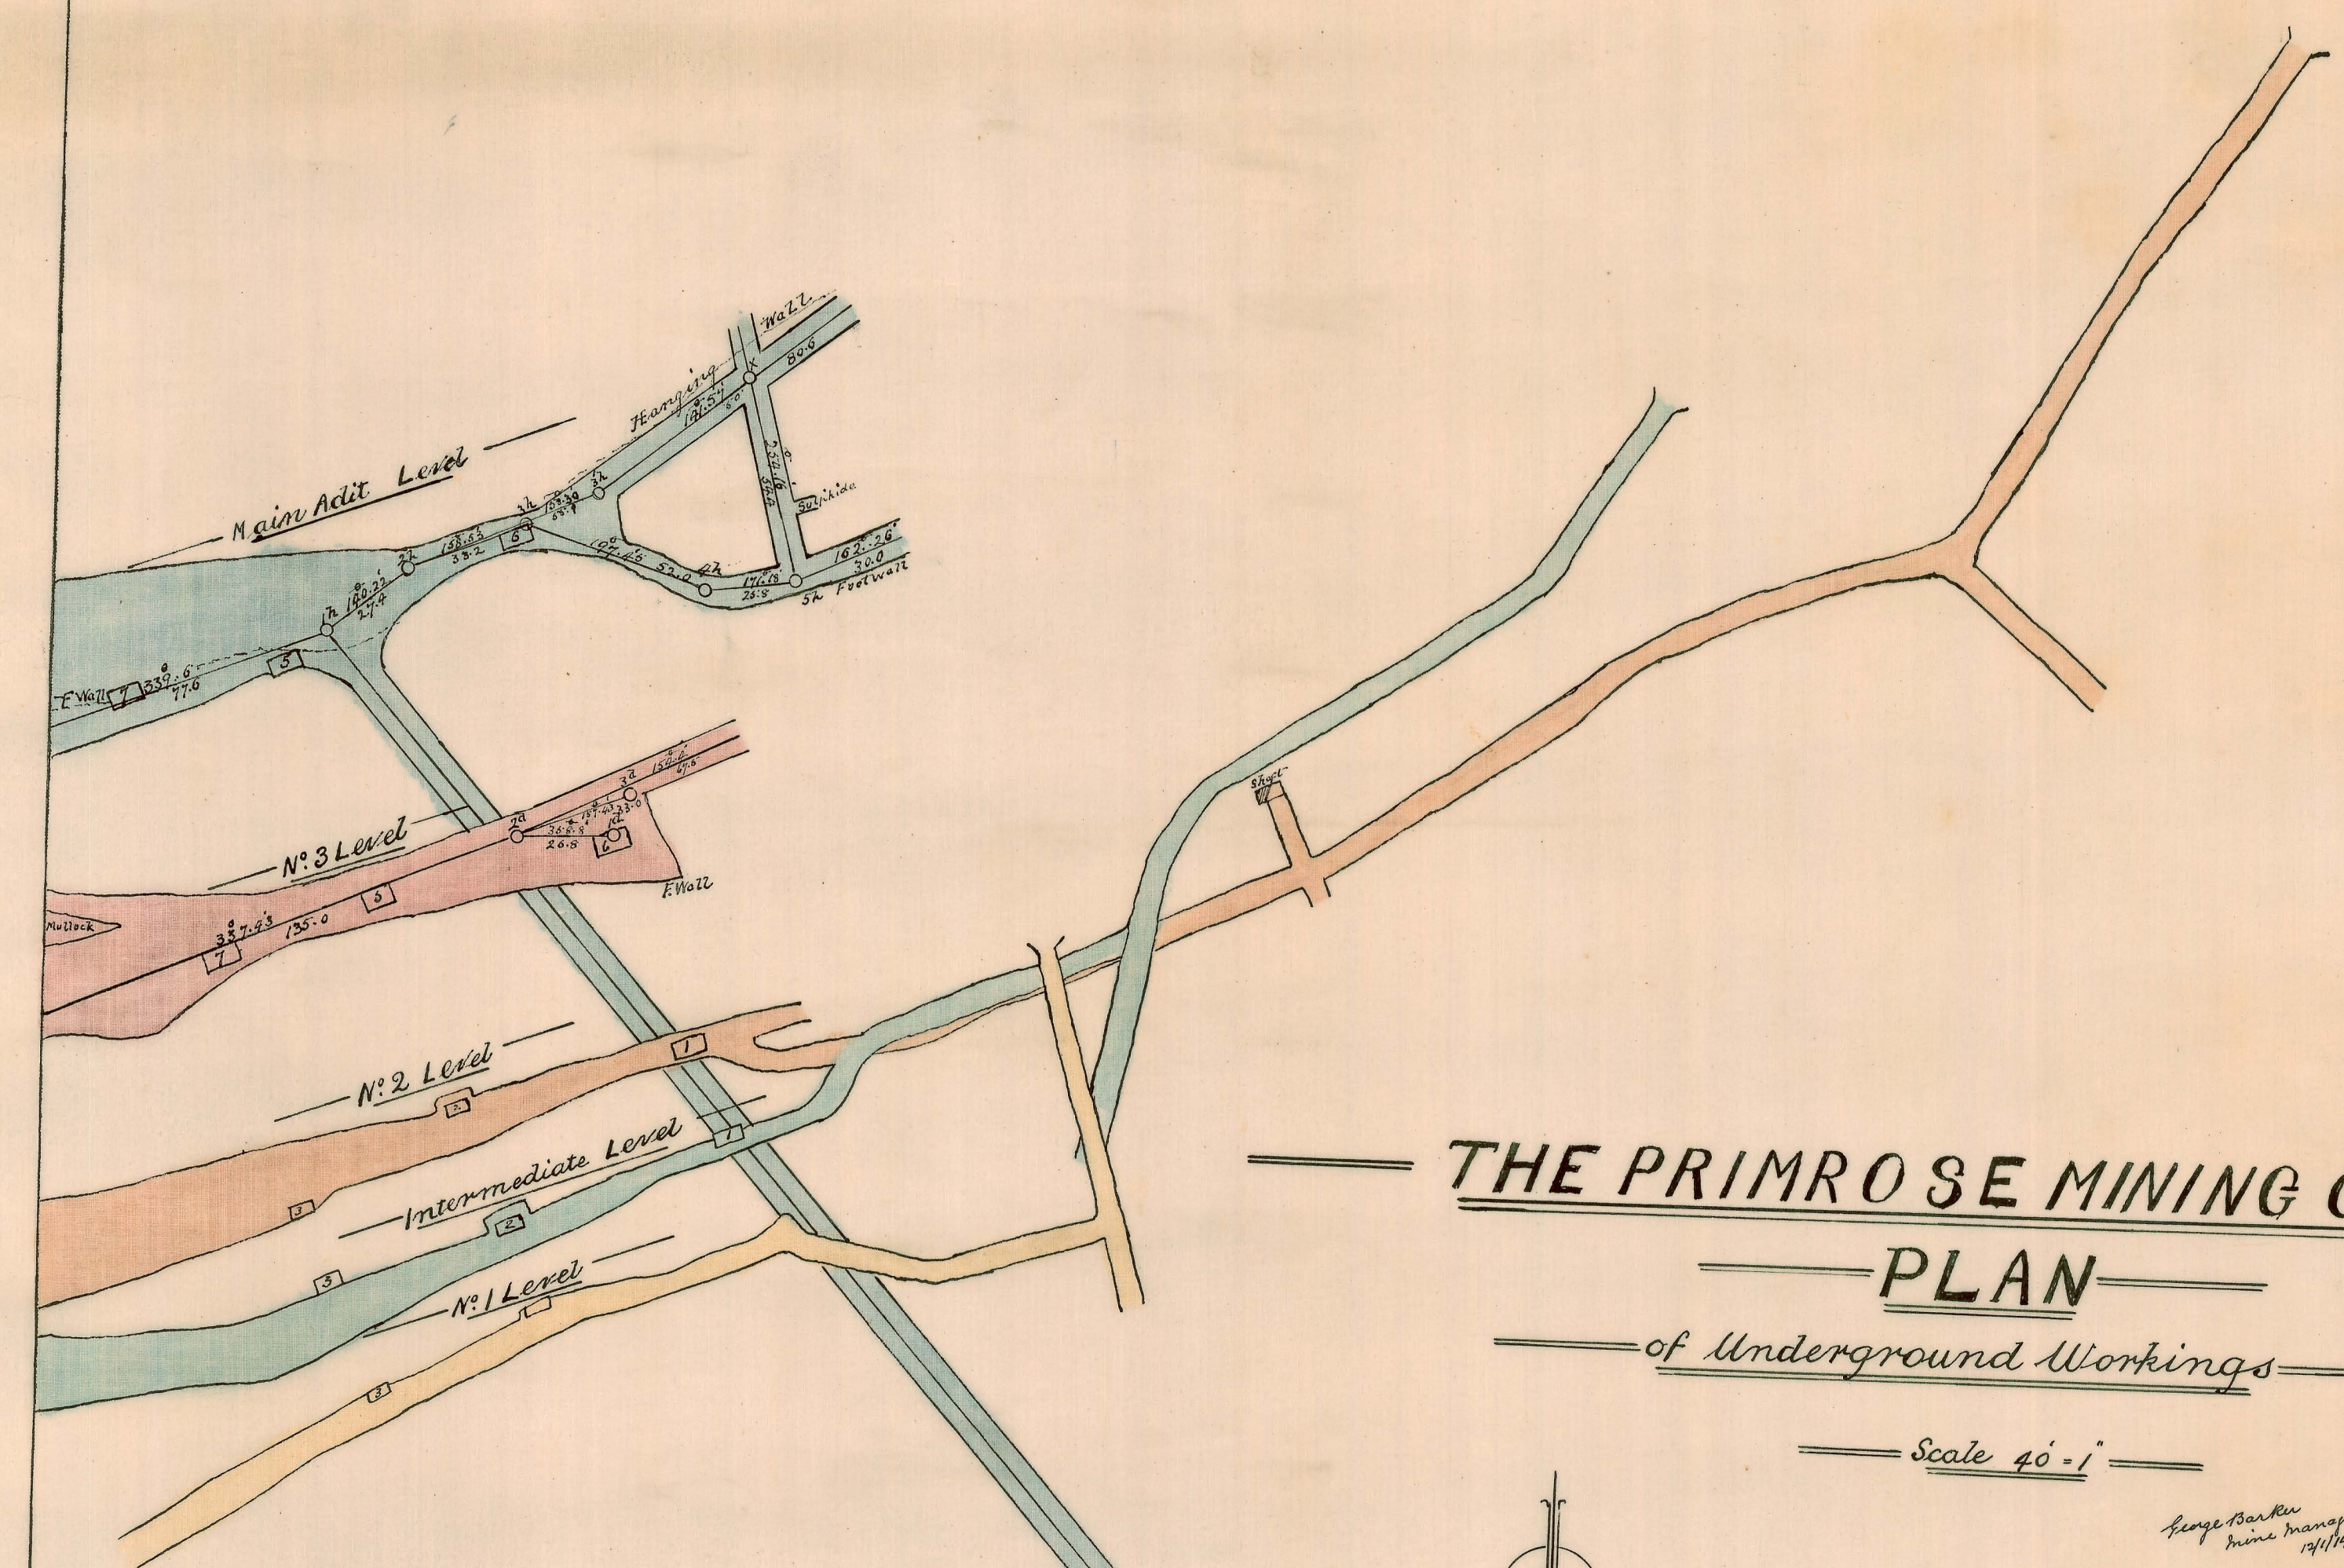

THE PRIMROSE MINING CO. LTD.
PLAN
of Underground Workings

Scale 40' = 1"



Large Section
Main Adit