310_02

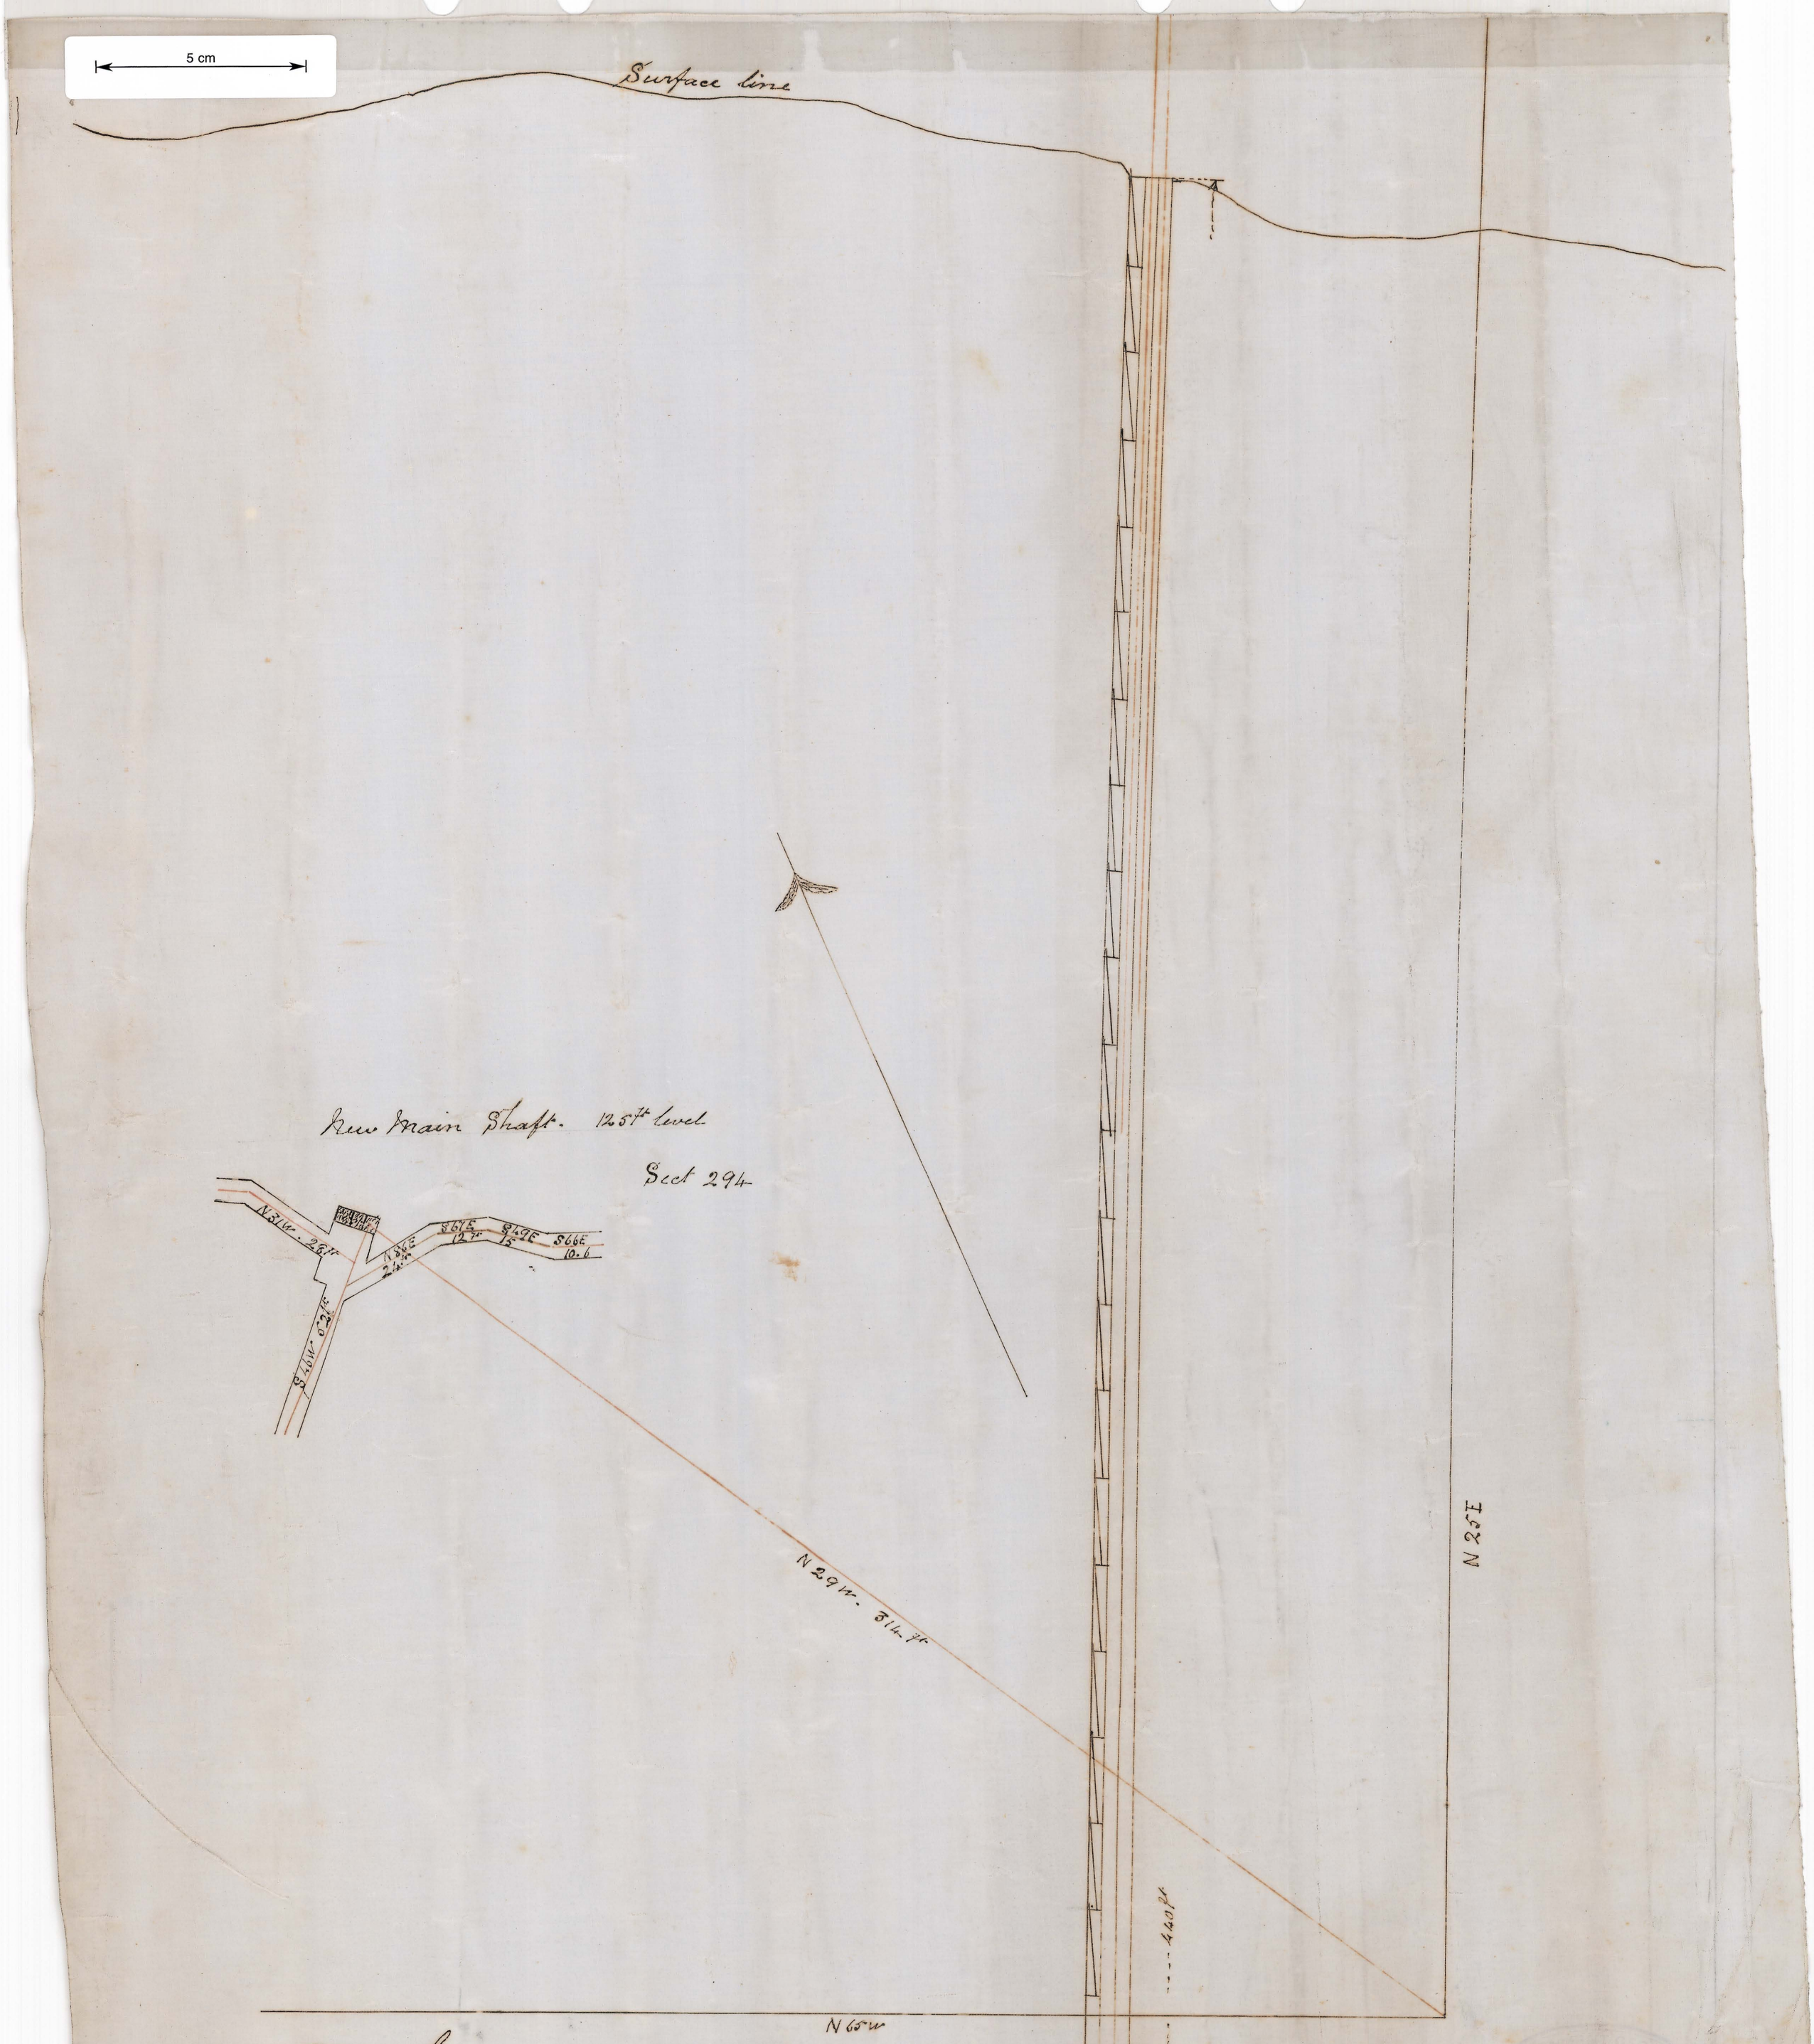

Plan of Little Wonder Main Shaft. 440 feet deep. Commenced 30th Nov. 1898

Scale 25ft to 1in

L. Deerey M. M.

Febuary 27th 1900

depth correct to date