


Man 1899
of regid mainmast

— SCALE —

0 5 10 15 20 25 50 F

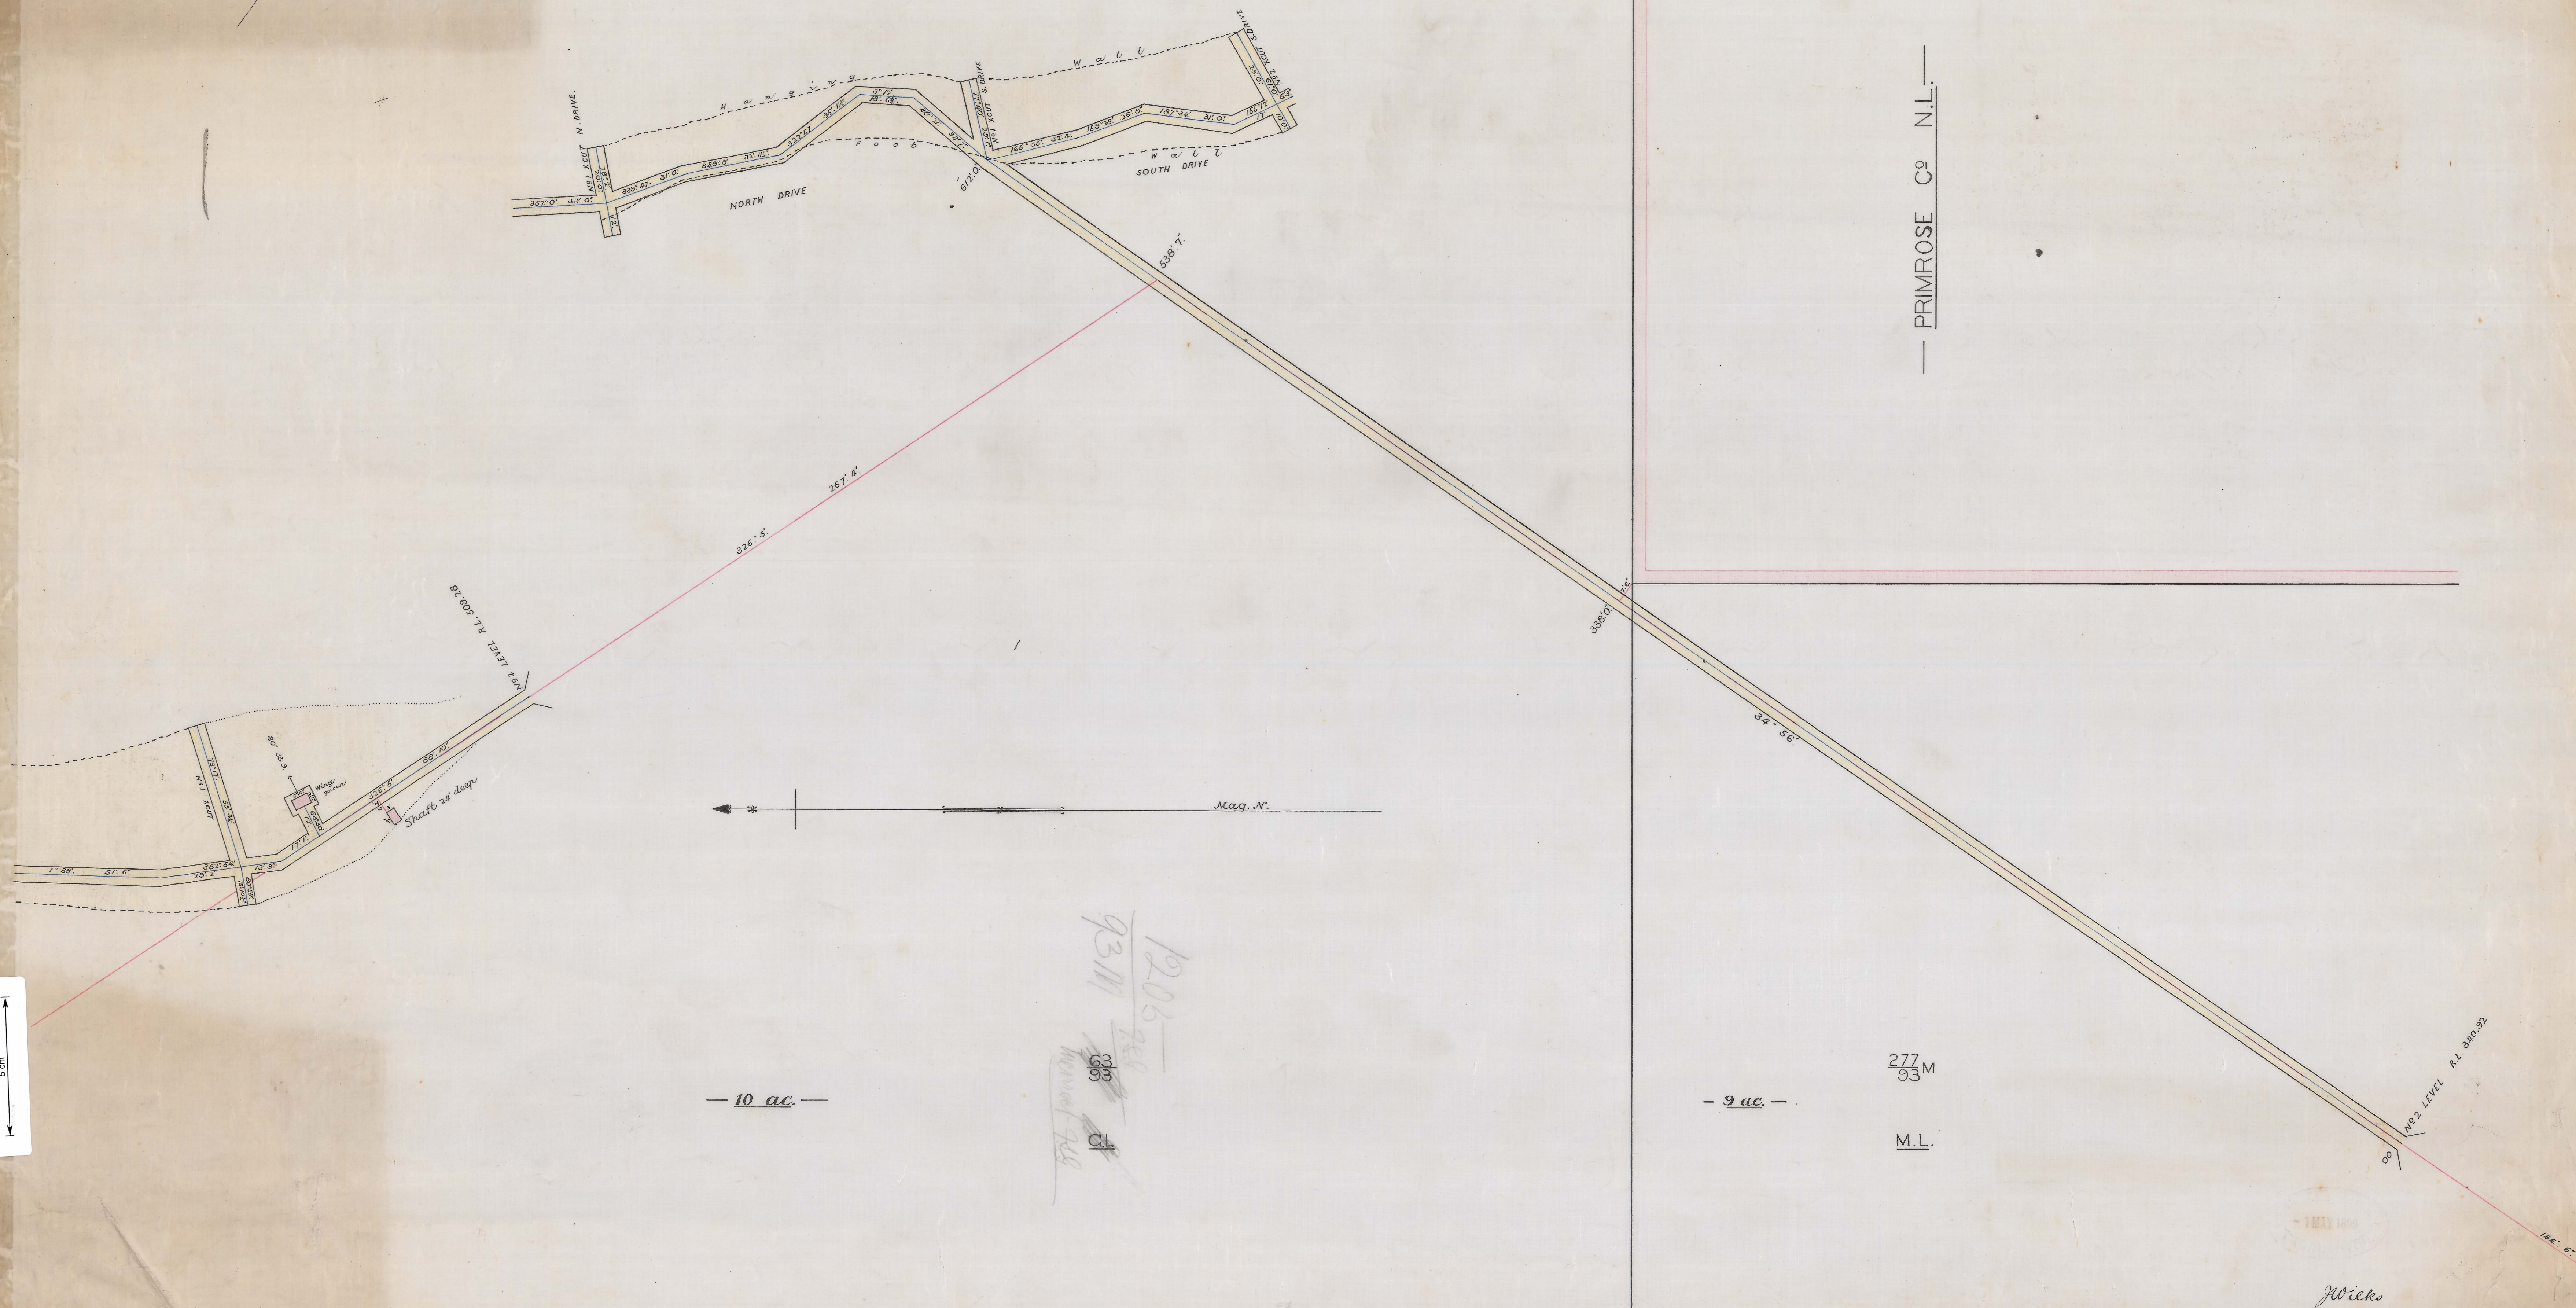

Wilks
Surveyor
March 23rd 1899

1205—
9311 200
93
93
C.L.