


TASMANIAN COPPER COMPANY

Rosebery Mine

Longitudinal Section

Scale 40ft to one inch

Reference
 No 2 Level
 Intermediate
 No 4 Level
 Ground Surface

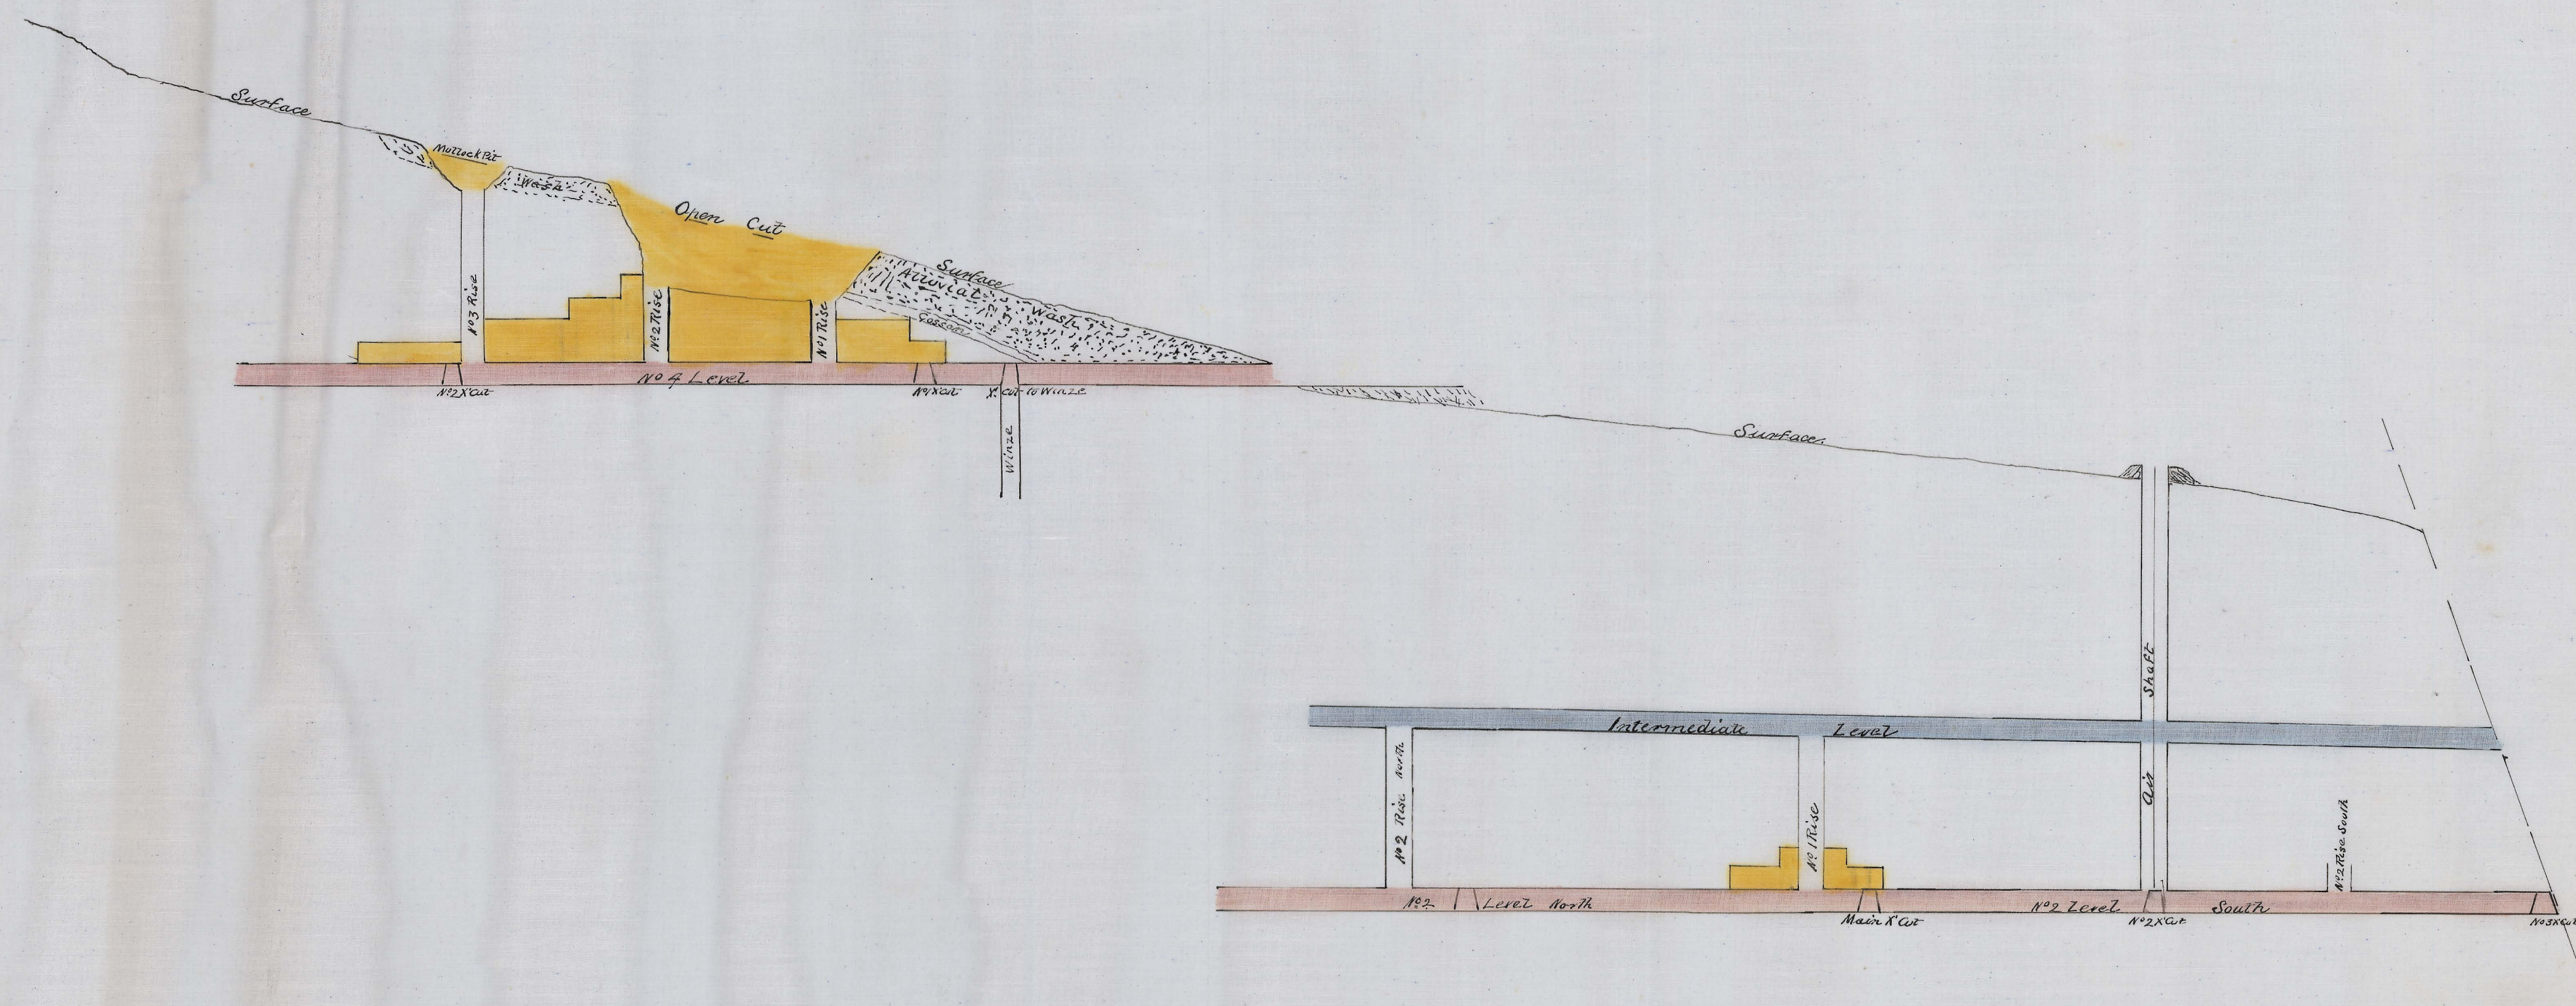

62 33m 1000
 Primrose Mining Company

5m

312
 09